


PARENT PARCEL: 05-00-057-000-221
CHILD PARCEL: 05-00-057-000-259, 260
STARTING POINT: c.l. of Dogwood Ct. & c.l. of Berry Ridge Rd.

NO. 22458

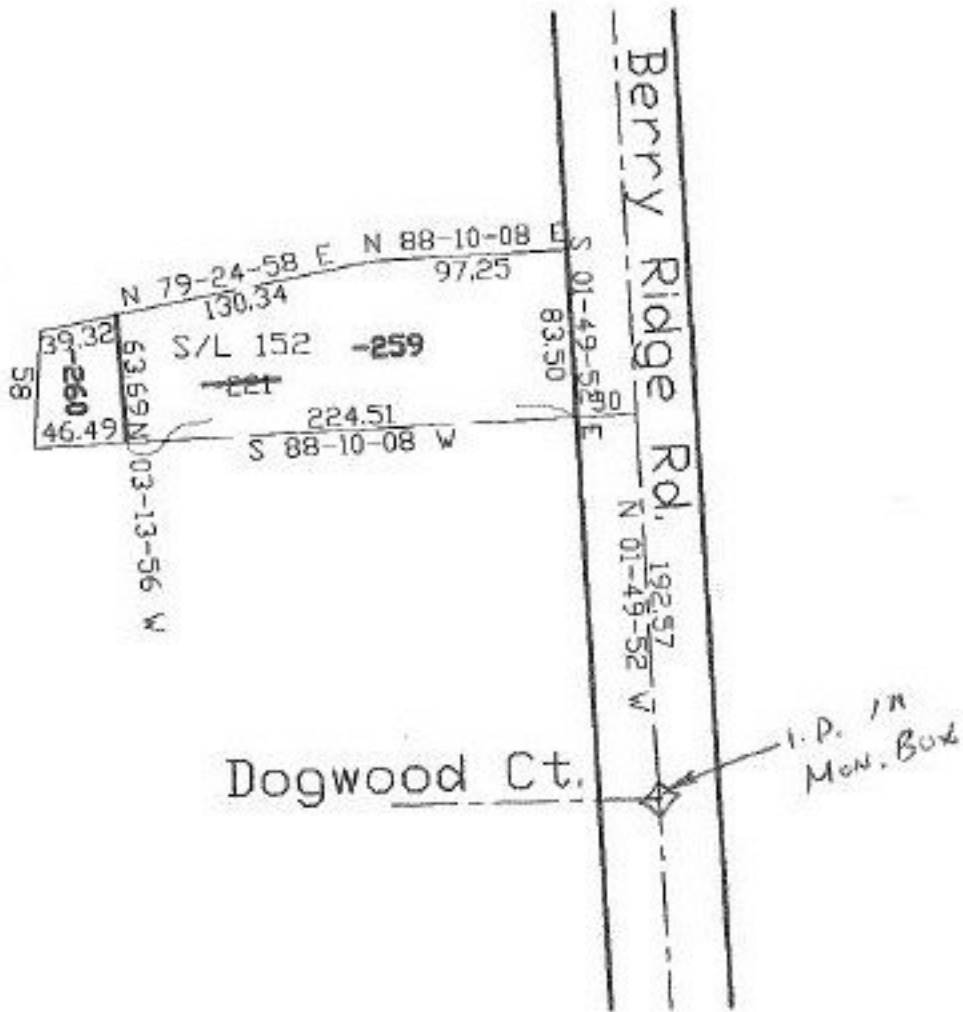

SPLITS/DEEDS PROCESSED
LORAIN COUNTY TAX MAP DEPARTMENT
226 MIDDLE AVE. ELYRIA, OHIO

SURVEYED BY: Patrick A. McGannon
CLOSURE: 0.10:10.000
MAP PAGE(S): 5-00-057-A
APPROVED BY: kac DATE: 3/31/98
SCALE: 1"=100' PRIOR INSTRUMENT: