

PARENT PARCEL: 05-00-057-000-219

CHILD PARCEL: 05-00-057-000-261, 262


STARTING POINT: cl. of Dogwood Ct. & cl. of Berry Ridge Rd.

NO. 22459

DEED 1: SPLITS -219 INTO -261 & -262

DEED 2: DESCRIBES -218 (S/L 155)  
-261 (PT. OF S/L 152)  
-262 (PT. OF S/L 154)

CANNOT COMBINE SUBLOTS

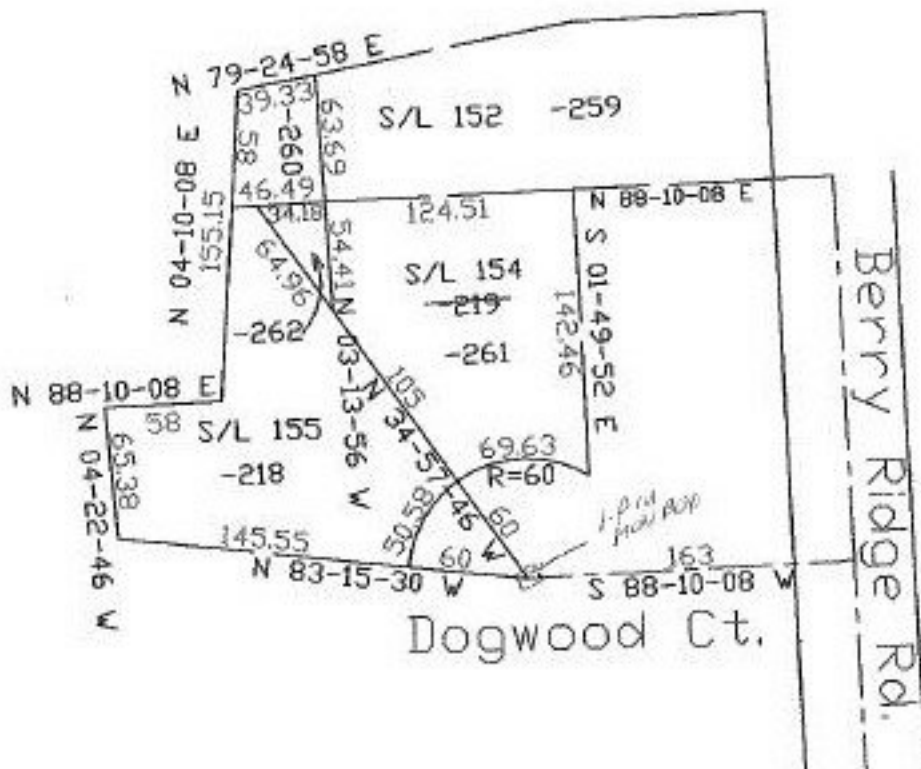

**SPLITS/DEEDS PROCESSED**  
LORAIN COUNTY TAX MAP DEPARTMENT  
226 MIDDLE AVE. ELYRIA, OHIO

SURVEYED BY: Patrick A. McGannon  
CLOSURE: 0.08:10.000  
MAP PAGE(S): 05-00-057-A  
APPROVED BY: kac DATE: 3/31/98  
SCALE: 1"=100' PRIOR INSTRUMENT: