
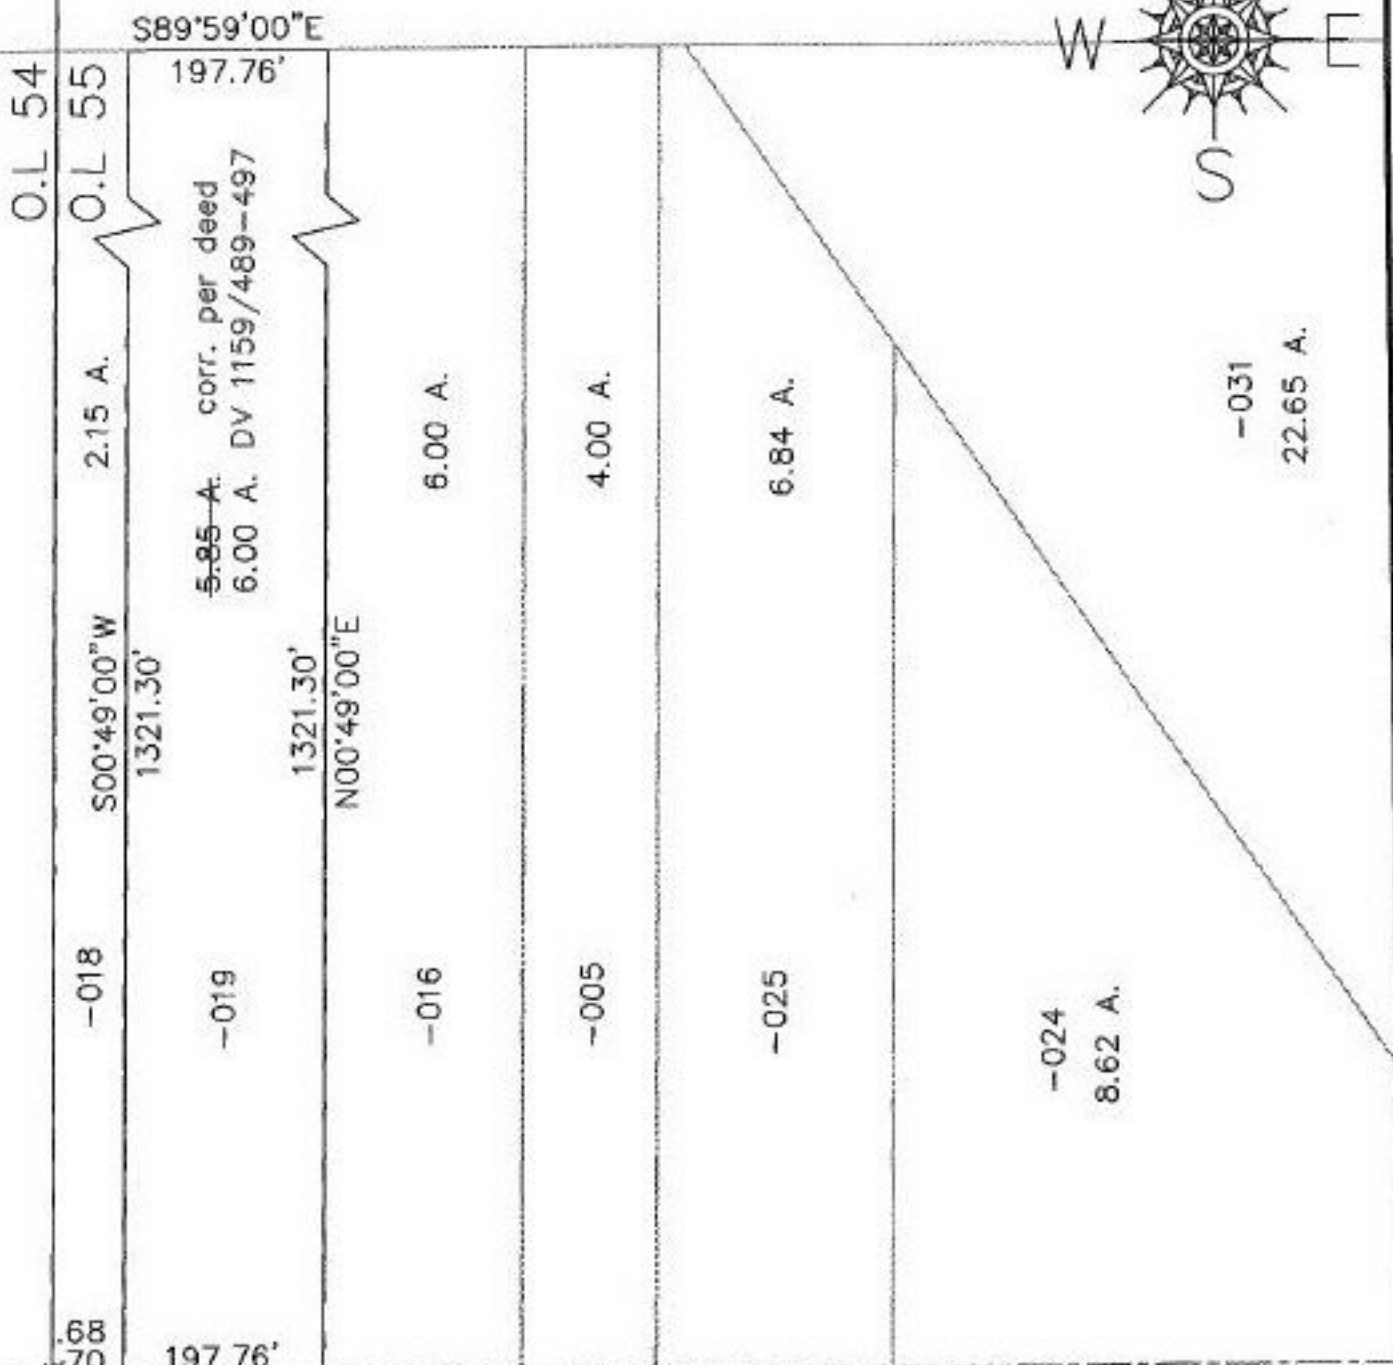


PARENT PARCEL: 09-00-055-000-019

NO. 22464-A

CHILD PARCEL:

STARTING POINT: cl. of Butternut Ridge Rd. & w. line of O.L. 55

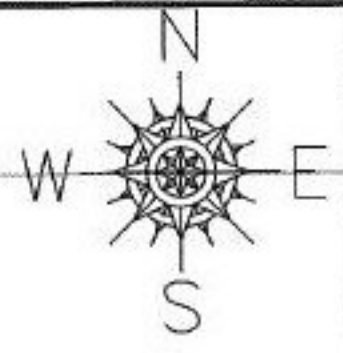

.68
70. 197.76'
N89°59'00\"W
MON. Box

Butternut Ridge Rd.



SPLITS/DEEDS PROCESSED
LORAIN COUNTY TAX MAP DEPARTMENT
226 MIDDLE AVE. ELYRIA, OHIO

SURVEYED BY: _____
CLOSURE: 0.00:10.000 SCALE: 1"= 200'
MAP PAGE(S): 9-F
APPROVED BY: kac DATE: 4/2/98
PRIOR INSTRUMENT: DV 1159/489-497

[Handwritten signature] 6/25/99