


PARENT PARCEL: 11-00-085-000-059, 061, 062  
CHILD PARCEL: 11-00-085-000-063, 064, 065  
STARTING POINT: cl. of Durkee Rd. & cl. of Elyria-Twinsburg Rd.

NO. 22467



Elyria-Twinsburg Rd.

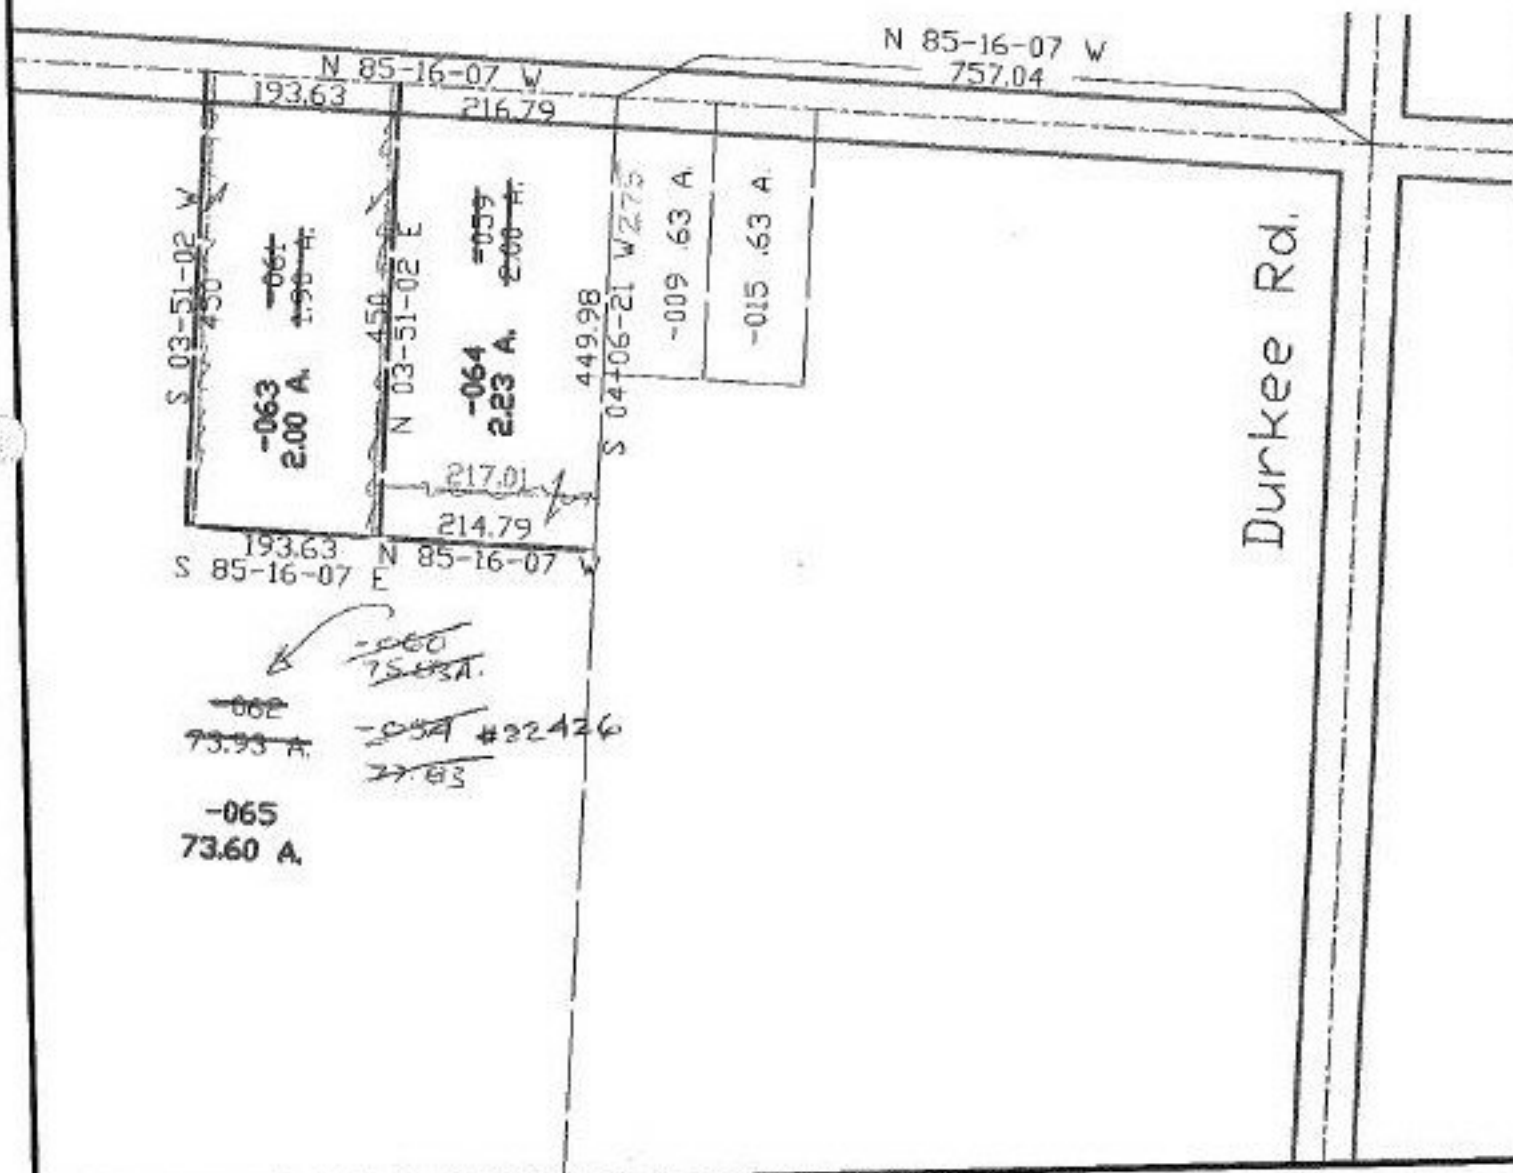

Durkee Rd.

1-28-99

**SPLITS/DEEDS PROCESSED**  
LORAIN COUNTY TAX MAP DEPARTMENT  
228 MIDDLE AVE. ELYRIA, OHIO

SURVEYED BY: David L. Elwell  
CLOSURE: 0.06:10,000  
MAP PAGE(S): 11-E  
APPROVED BY: kac DATE: 3/19/98  
SCALE: 1" = 200' PRIOR INSTRUMENT: #980516370