
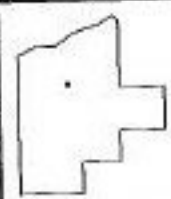


PARENT PARCEL: 04-00-023-108-120

CHILD PARCEL: 04-00-023-108-123, 124

STARTING POINT: cl. of Schwartz Rd. & cl. of Jaycox Rd.

NO. 22468

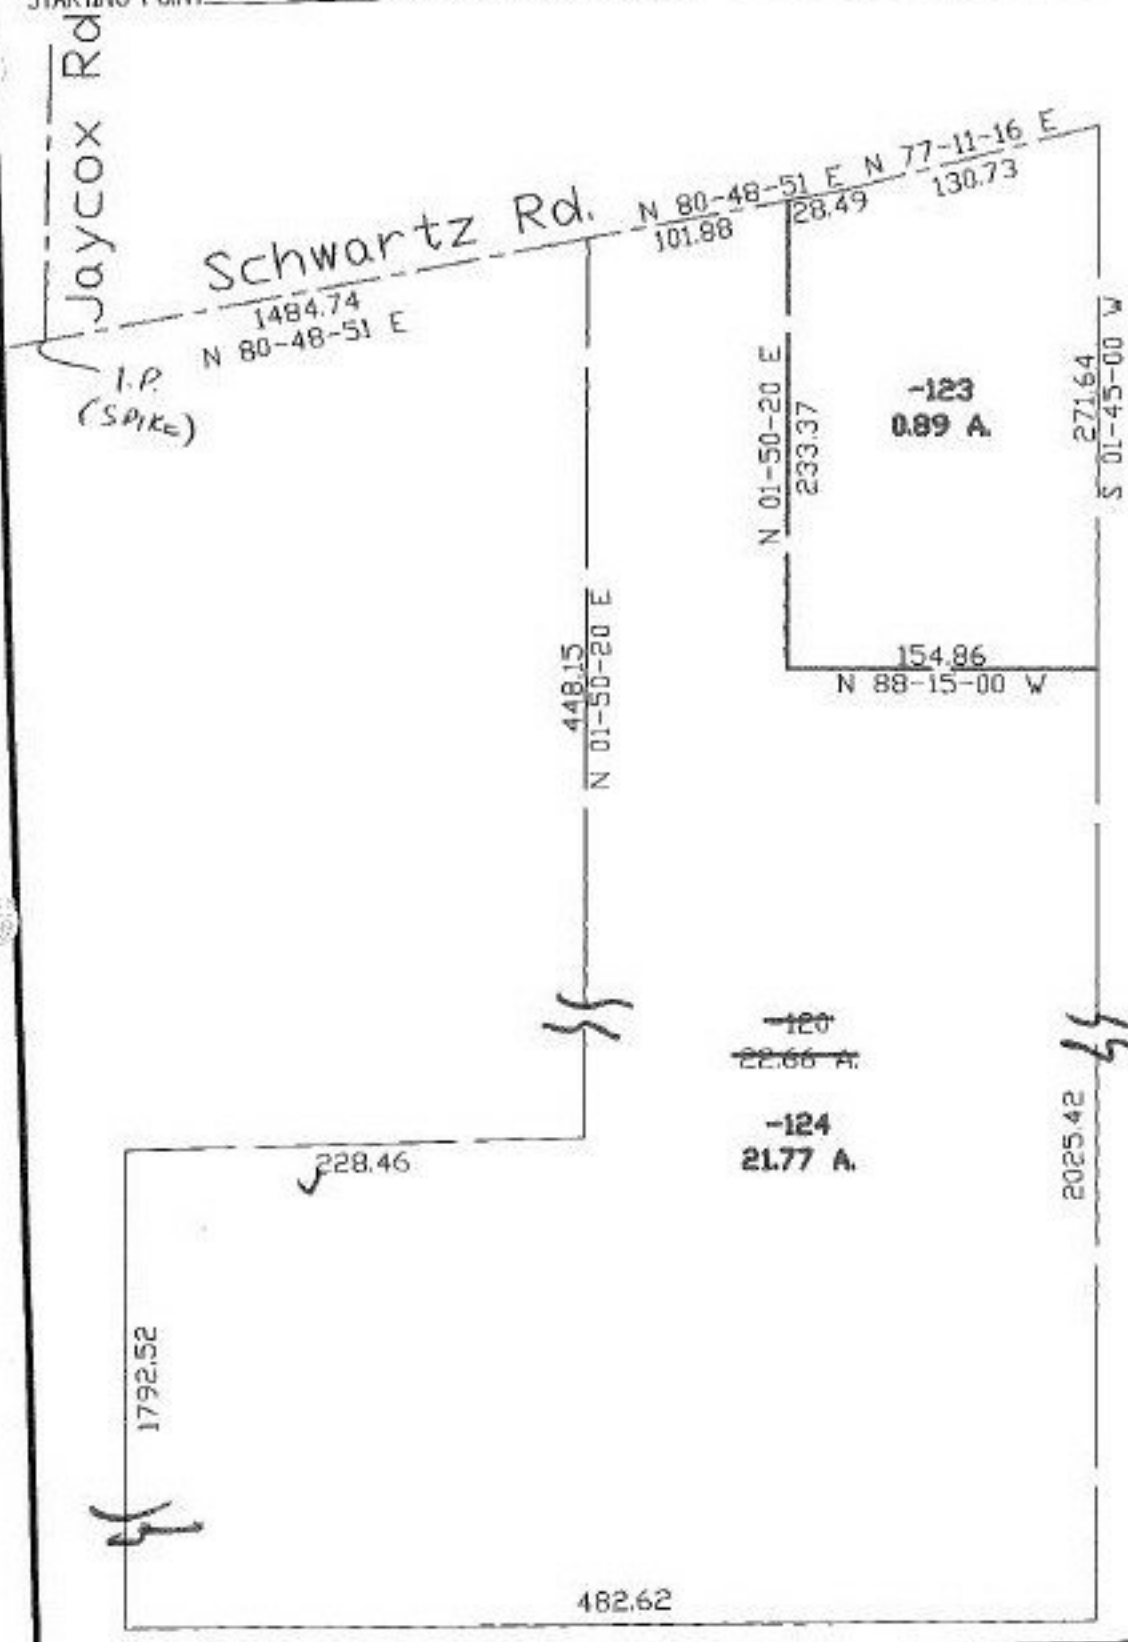

SPLITS/DEEDS PROCESSED
 LORAIN COUNTY TAX MAP DEPARTMENT
 226 MIDDLE AVE. ELYRIA, OHIO

SURVEYED BY: David L. Elwell
 CLOSURE: 0.08:10.000
 MAP PAGE(S): 04-00-023-G
 APPROVED BY: kac DATE: 3/16/98
 SCALE: 1" = 100' PRIOR INSTRUMENT: