


N. Y. C. 2334.75
2335.26 5.37A.
600-001
2385

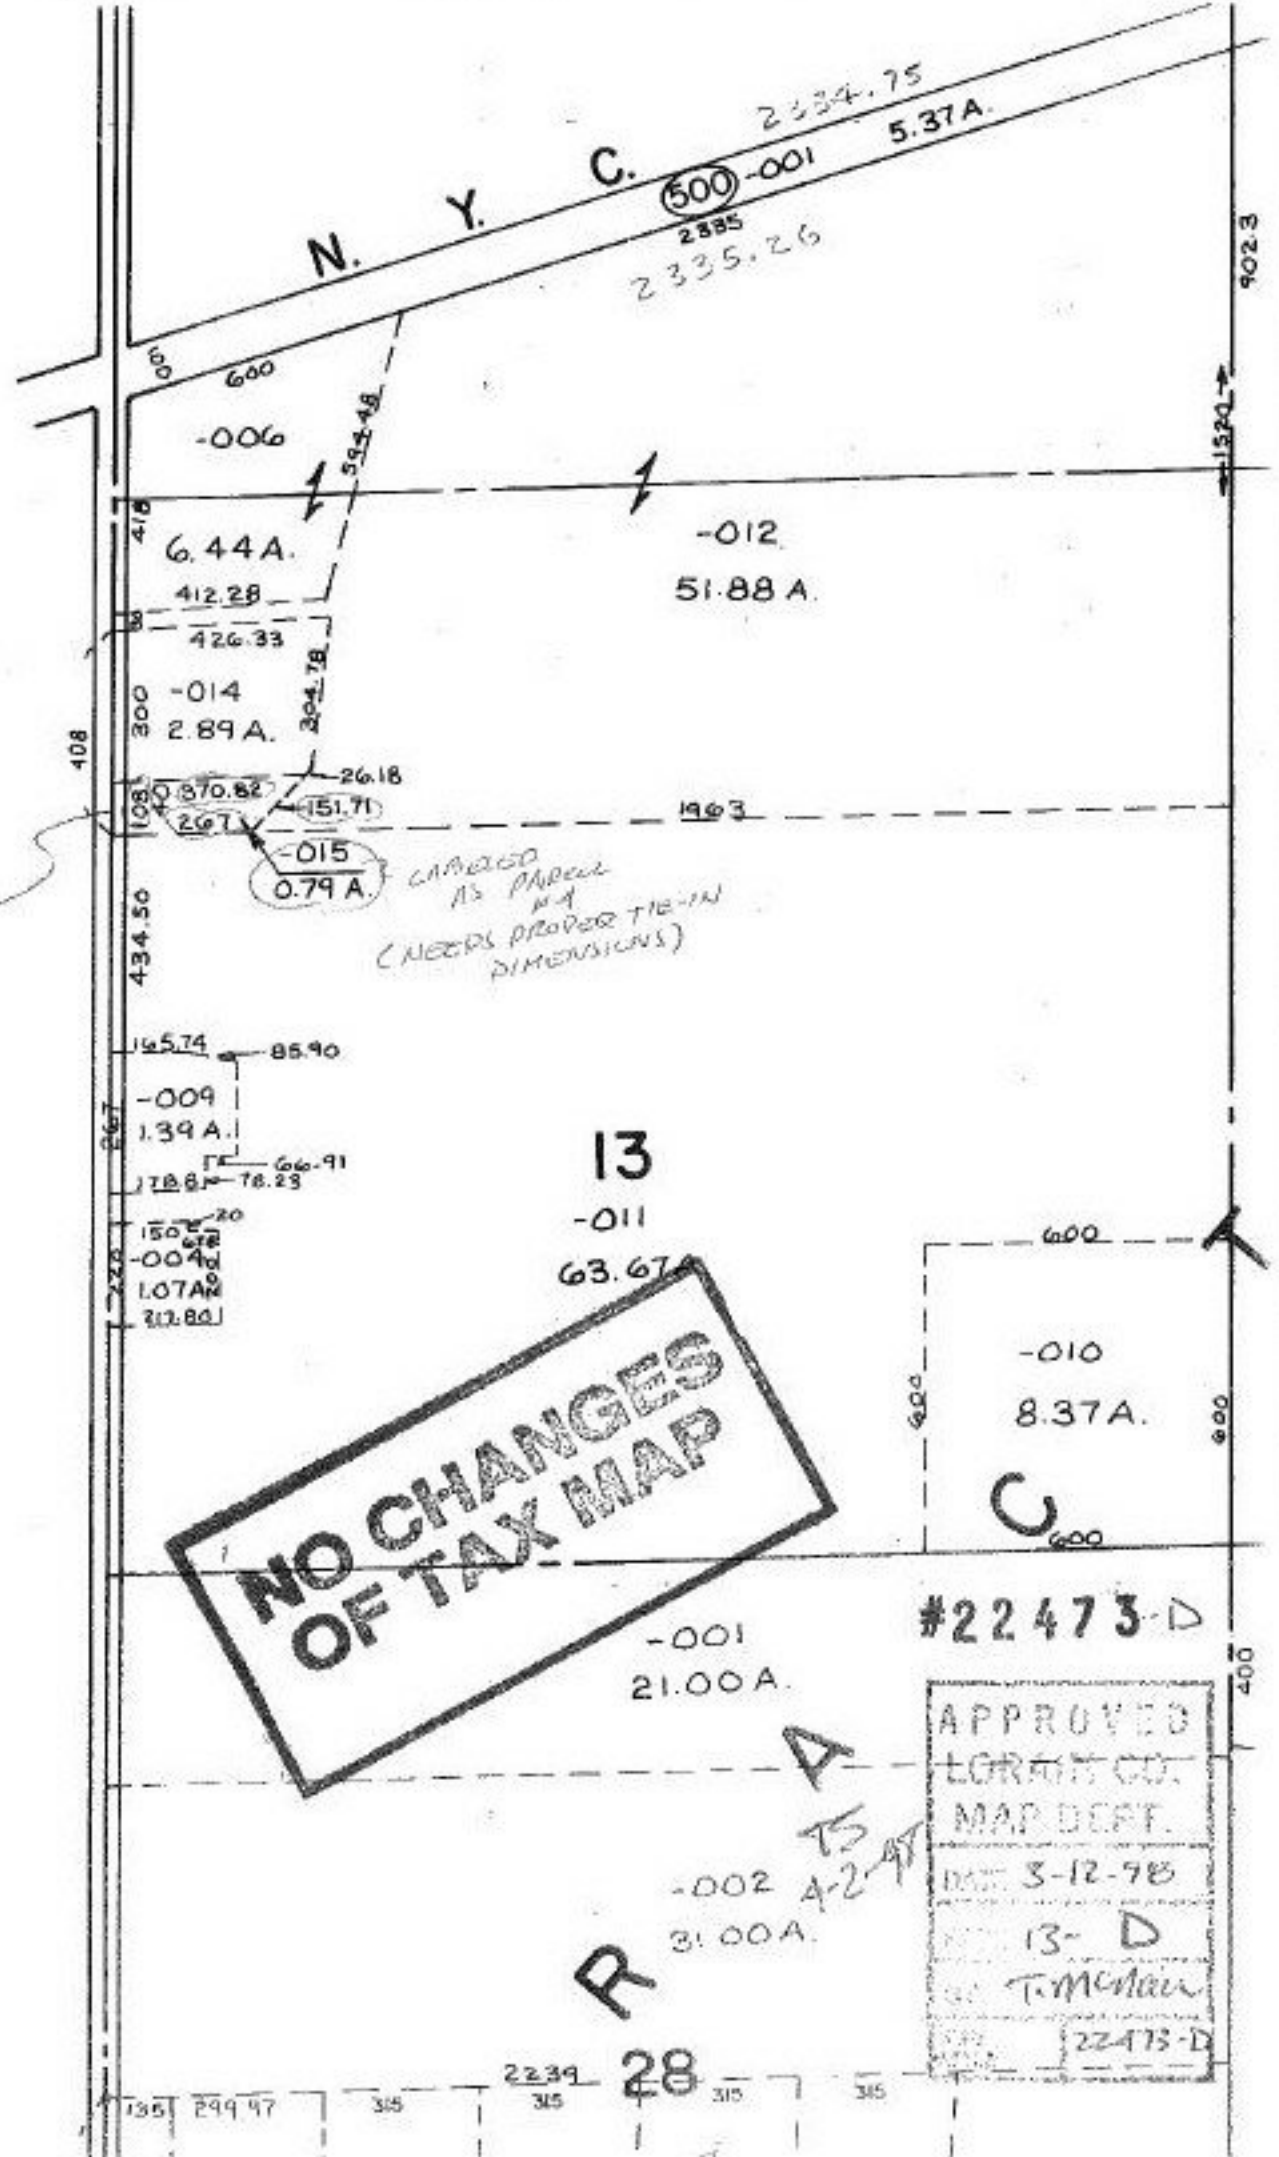

#22473-D

**NO CHANGES
OF TAX MAP**

LARGE AS PARCEL #4
(NEEDS PROPER TIE-IN
DIMENSIONS)

#22473-D

APPROVED
LORAIN CO.
MAP DEPT.
DATE 3-12-78
13-D
T. McNamee
22473-D

R 28
A
TS
A-2-98

2239 28
135 299.97 315 315 315 315