


PARENT PARCEL: 07-00-038-000-094, 024
CHILD PARCEL: 07-00-038-000-126
STARTING POINT: c.l. of Sugar Ridge Rd. & west line of O.L. 38

NO. 22474

West line of O.L. 38

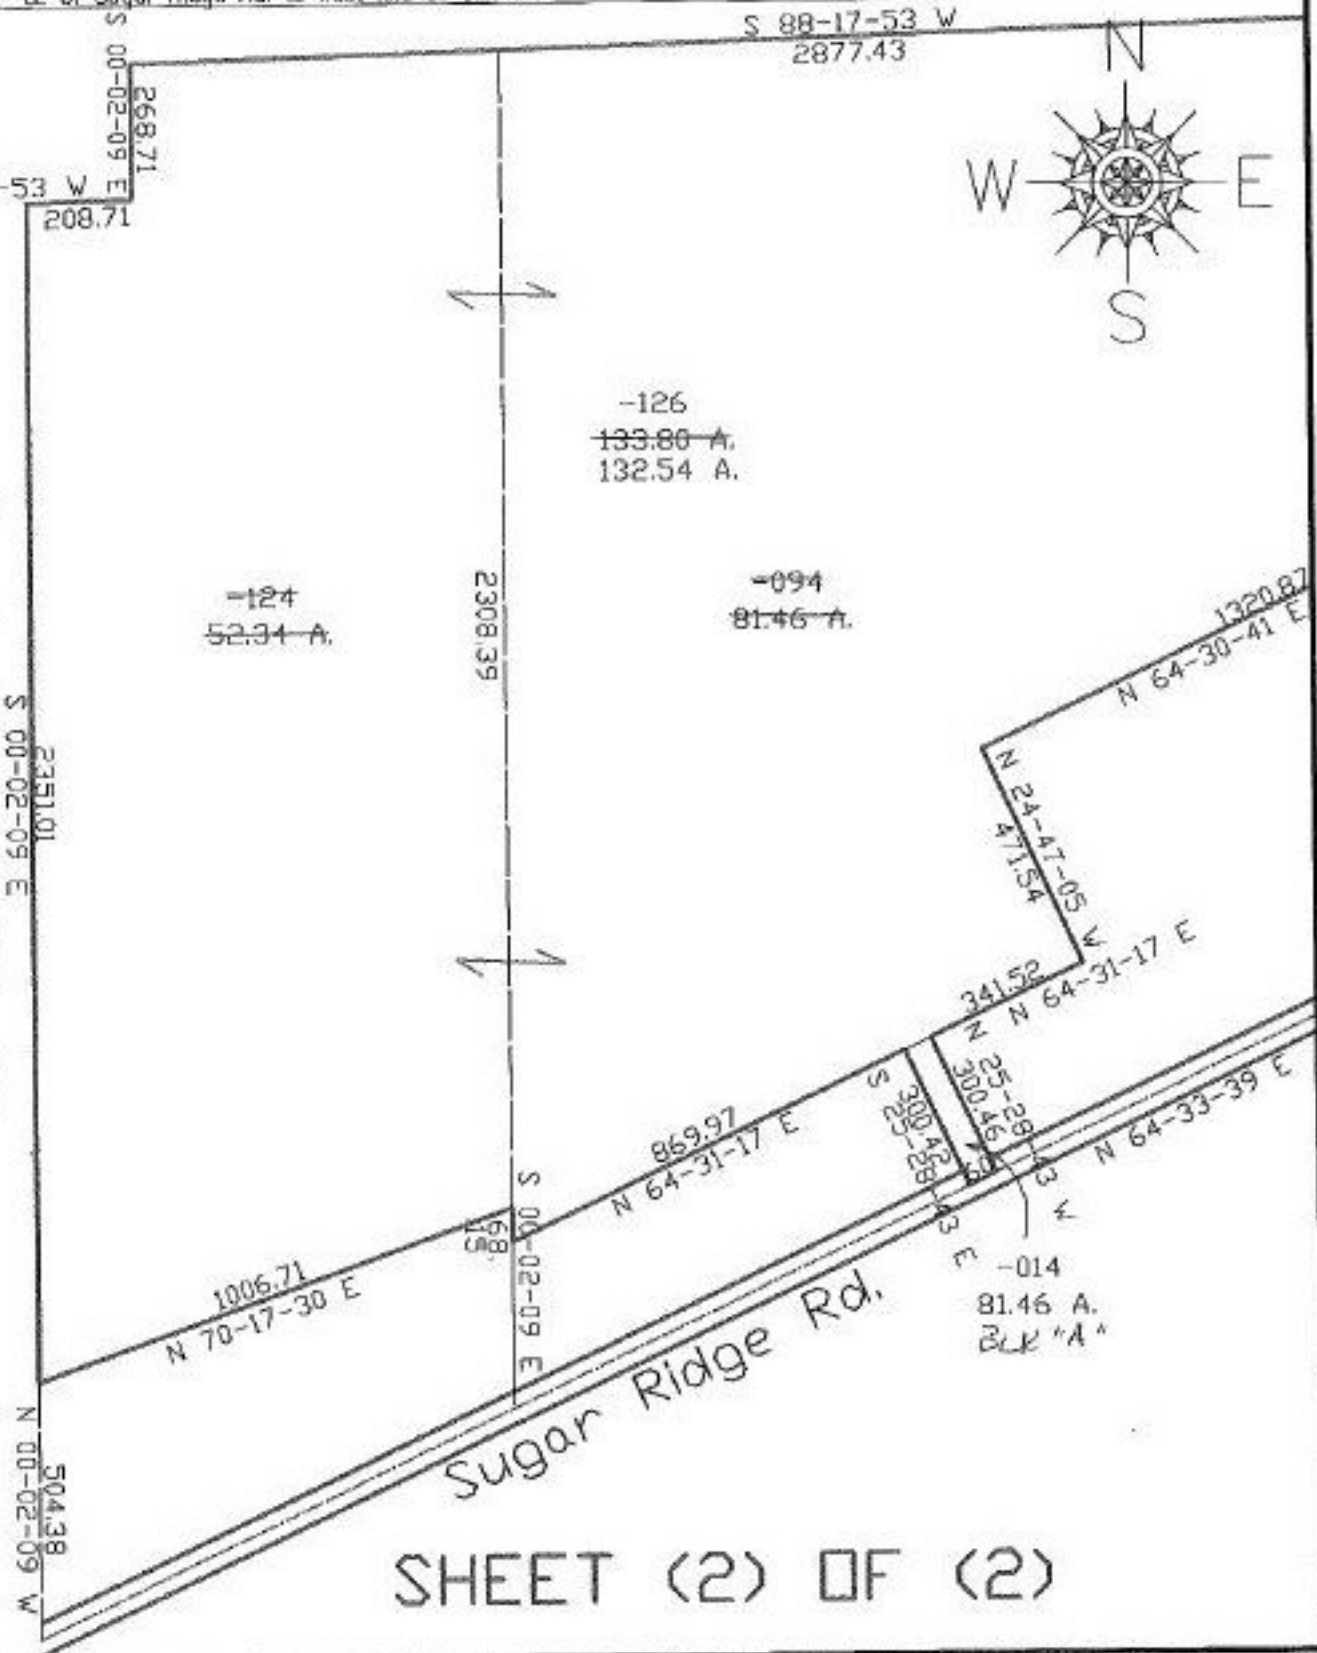

SHEET (2) OF (2)



SPLITS/DEEDS PROCESSED
LORAIN COUNTY TAX MAP DEPARTMENT
226 MIDDLE AVE. ELYRIA, OHIO

SURVEYED BY: Dana A. Hoponek
CLOSURE: 0.01:10.000
MAP PAGE(S): 07-00-038-8, 7-E
APPROVED BY: kac DATE: 3/18/98
SCALE: 1" = 400' PRIOR INSTRUMENT: DV 1348/560 #970508637