


233.47  
173.77  
43.00

N. Y. C. & ST. L.

-009 WAS A  
COMB. 10/11/63  
OF -001 & 002

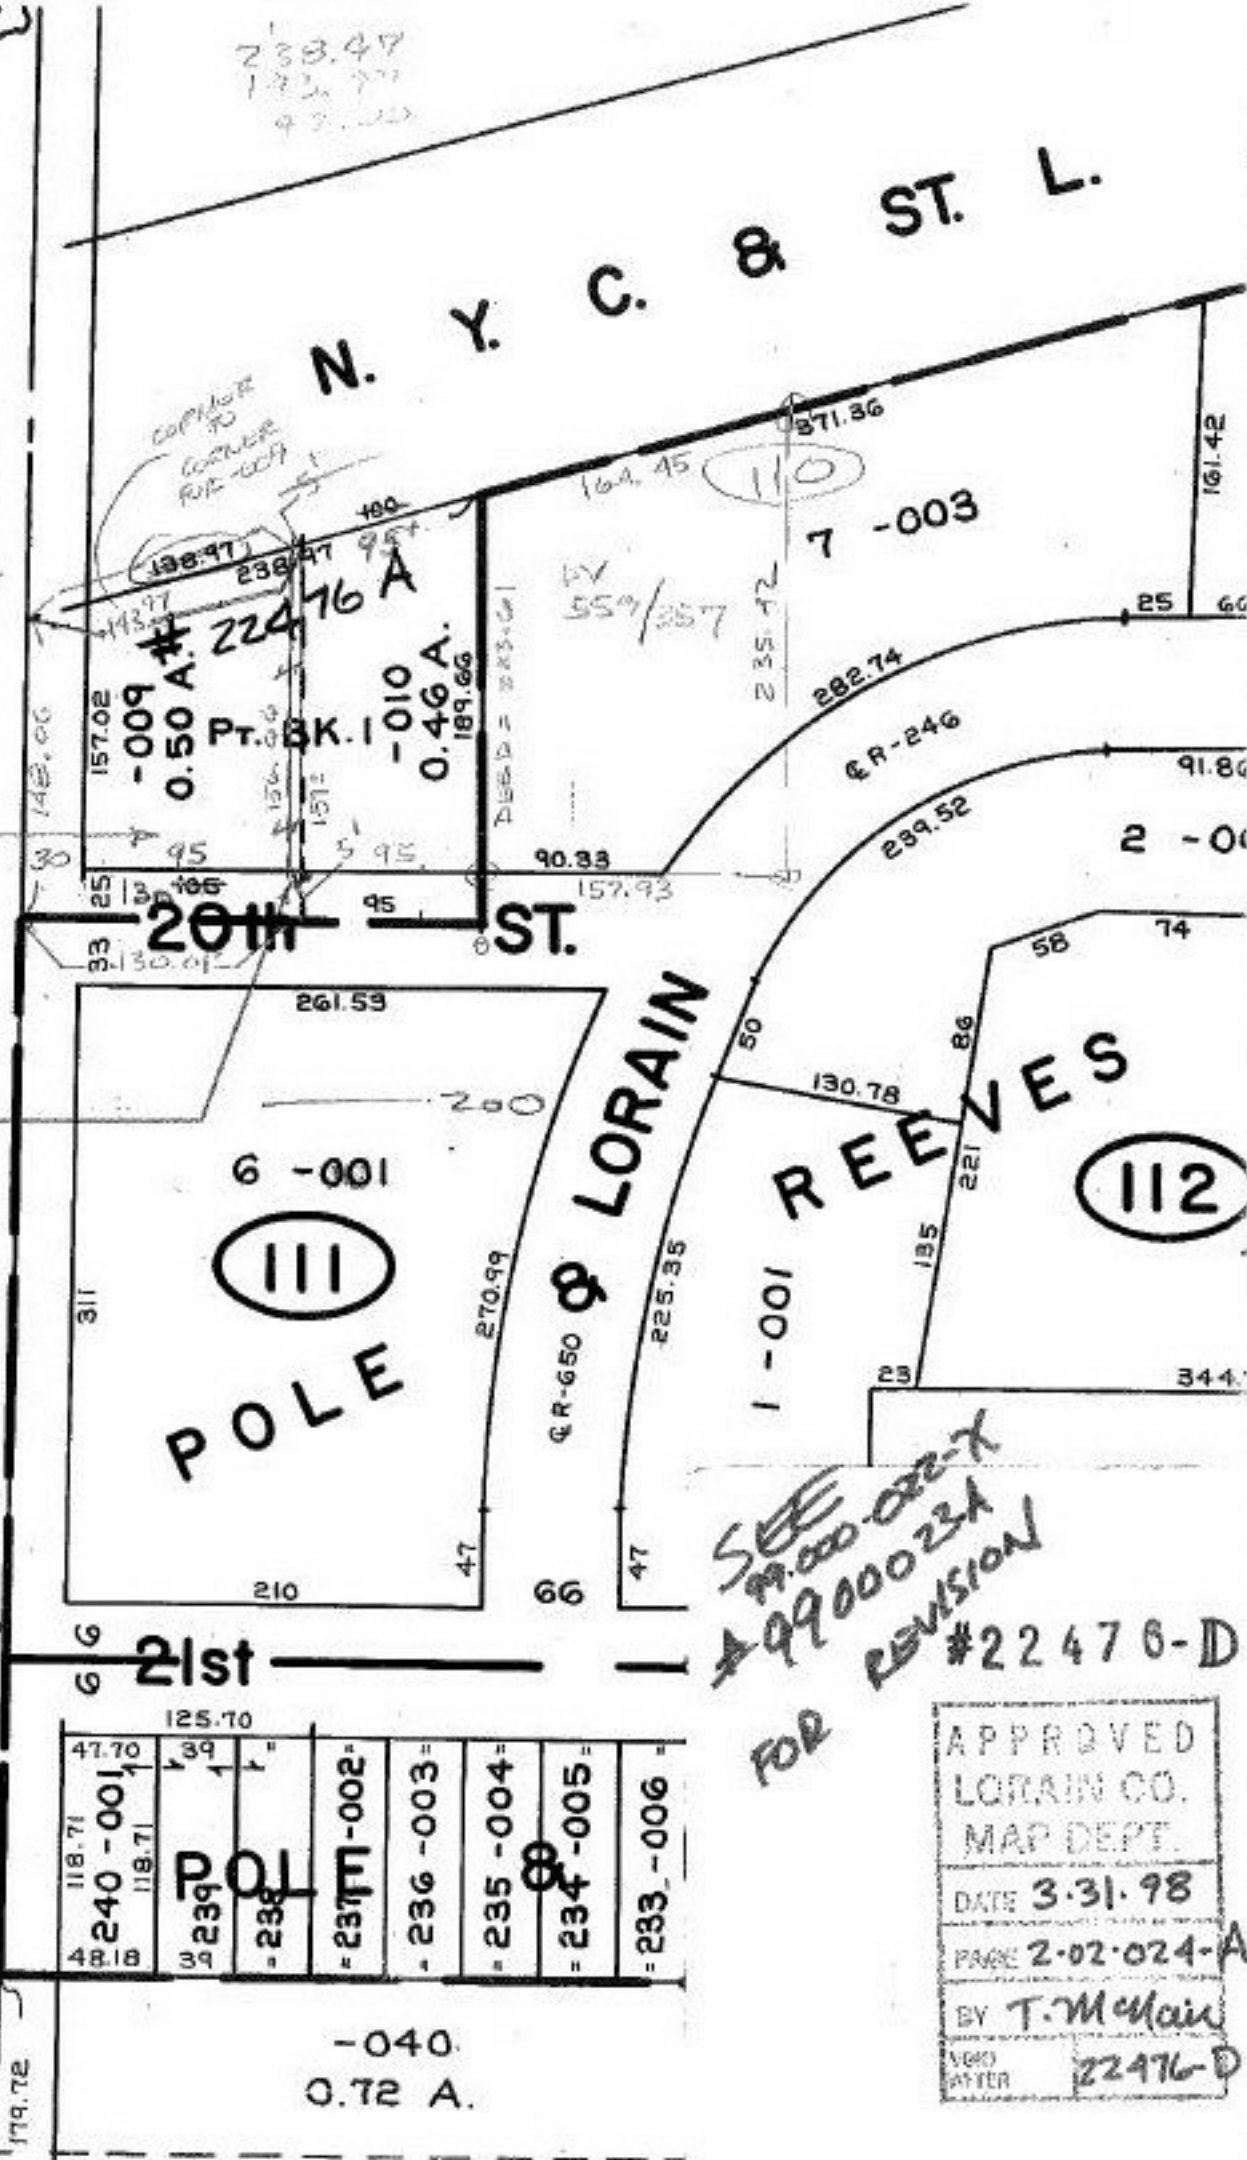

SEE  
DV 859/P.173  
780526904  
3/31/98

SEE  
DV 859/P.177  
2/17/90

DEED TO BE  
REFILED  
THAT INCLUDES  
HOOKED IN S' STRIP  
ON EAST SIDE OF  
-009

138.97  
5.00  
143.97  
0.478 A.  
0.018  
0.496

SEE  
99000022-X  
9900023A  
REVISION  
#22476-D  
FOR

APPROVED LORAIN CO. MAP DEPT.	
DATE	3.31.98
PAGE	2-02-024-A
BY	T. McLean
VIDEO METER	22476-D

118.71	47.70	125.70					
240-001	118.71	39	237-002	236-003	235-004	234-005	233-006
48.18	39	1					

-040  
0.72 A.