


PARENT PARCEL: 09-00-084-107-026

CHILD PARCEL:

STARTING POINT:

NO. 22477-A

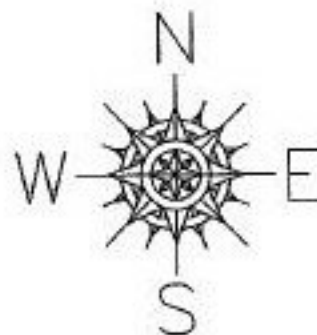

DEED CHECK

09-00-084-107-026

~~10 x 117~~

5 x 117

CORR. PER DEED
DV 945/527

SEE 99-00012-X
FOR PARCEL SIZE
CORRECTION

DEED FILED W\ CORRECTION
TO FOLLOW



SPLITS/DEEDS PROCESSED
LORAIN COUNTY TAX MAP DEPARTMENT
226 MIDDLE AVE. ELYRIA, OHIO

SURVEYED BY: _____
CLOSURE: _____
MAP PAGE(S): 09-00-084-b
APPROVED BY: KAC DATE: 3/23/98
SCALE: 1" = 100' PRIOR INSTRUMENT: DV 945/527