


PARENT PARCEL: 06-24-001-000-051


CHILD PARCEL: 06-24-001-000-063, 064, 065, 066

STARTING POINT: cl. of West Ridge Rd. & cl. of Albrecht Rd.

NO. 22477

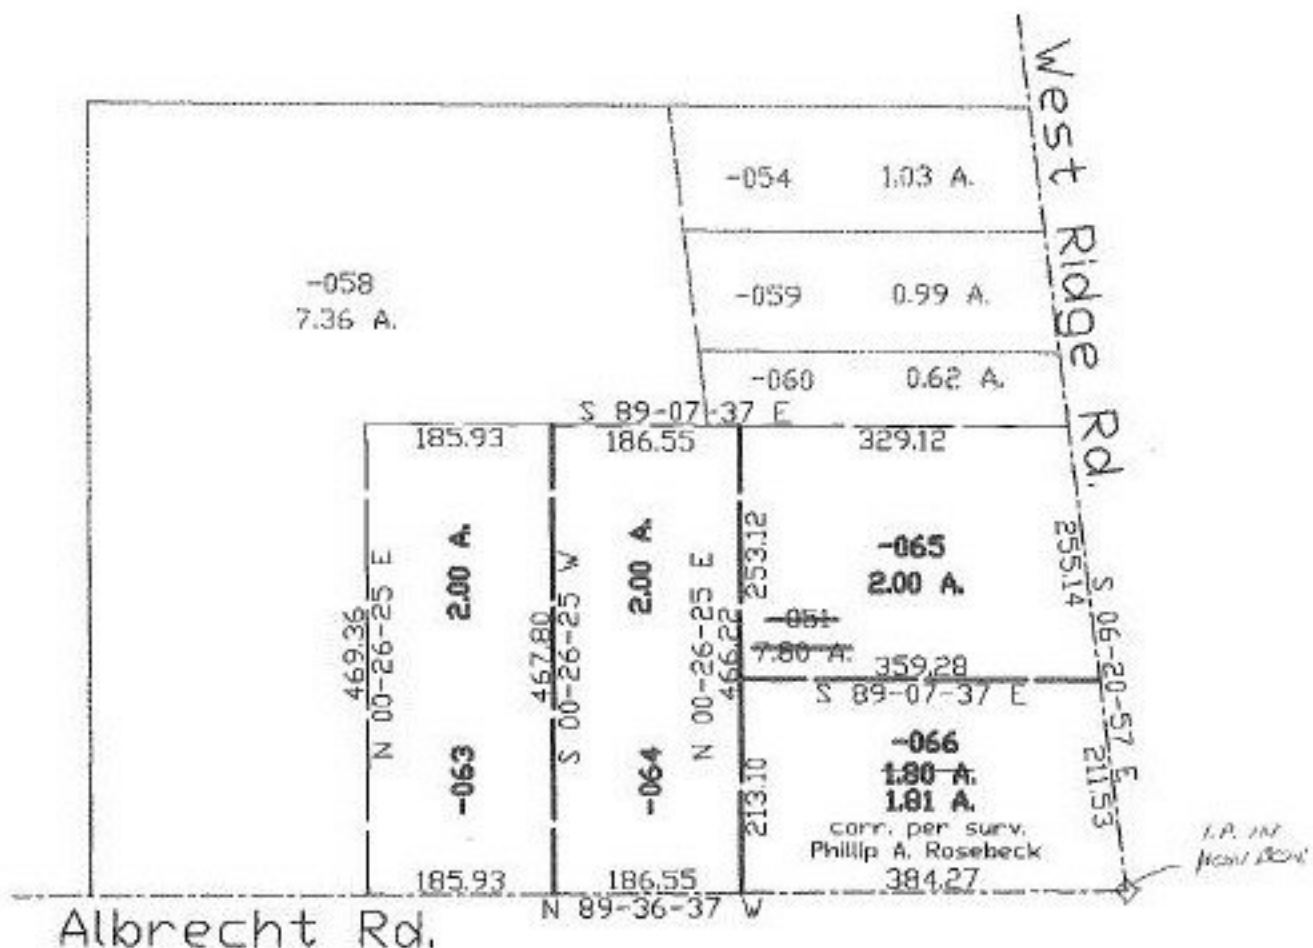

I.P. INT
North Arrow

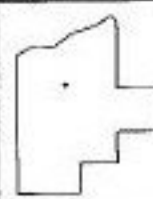

SPLITS/DEEDS PROCESSED
LORAIN COUNTY TAX MAP DEPARTMENT
226 MIDDLE AVE. ELYRIA, OHIO

SURVEYED BY: Phillip A. Rosebeck
CLOSURE: 0.08:10,000
MAP PAGE(S): 6-128
APPROVED BY: kac DATE: 3/23/98
SCALE: 1" = 200' PRIOR INSTRUMENT: #970509603