
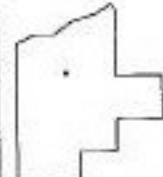


PARENT PARCEL: 07-00-001-000--036, 048, 062

CHILD PARCEL: 07-00-001-000-082 thru -087

STARTING POINT: cl. of Sprague Rd. & SE corner of O.L. 1 and cl. of Sprague Rd. & cl. of Root Rd.

NO. 22479

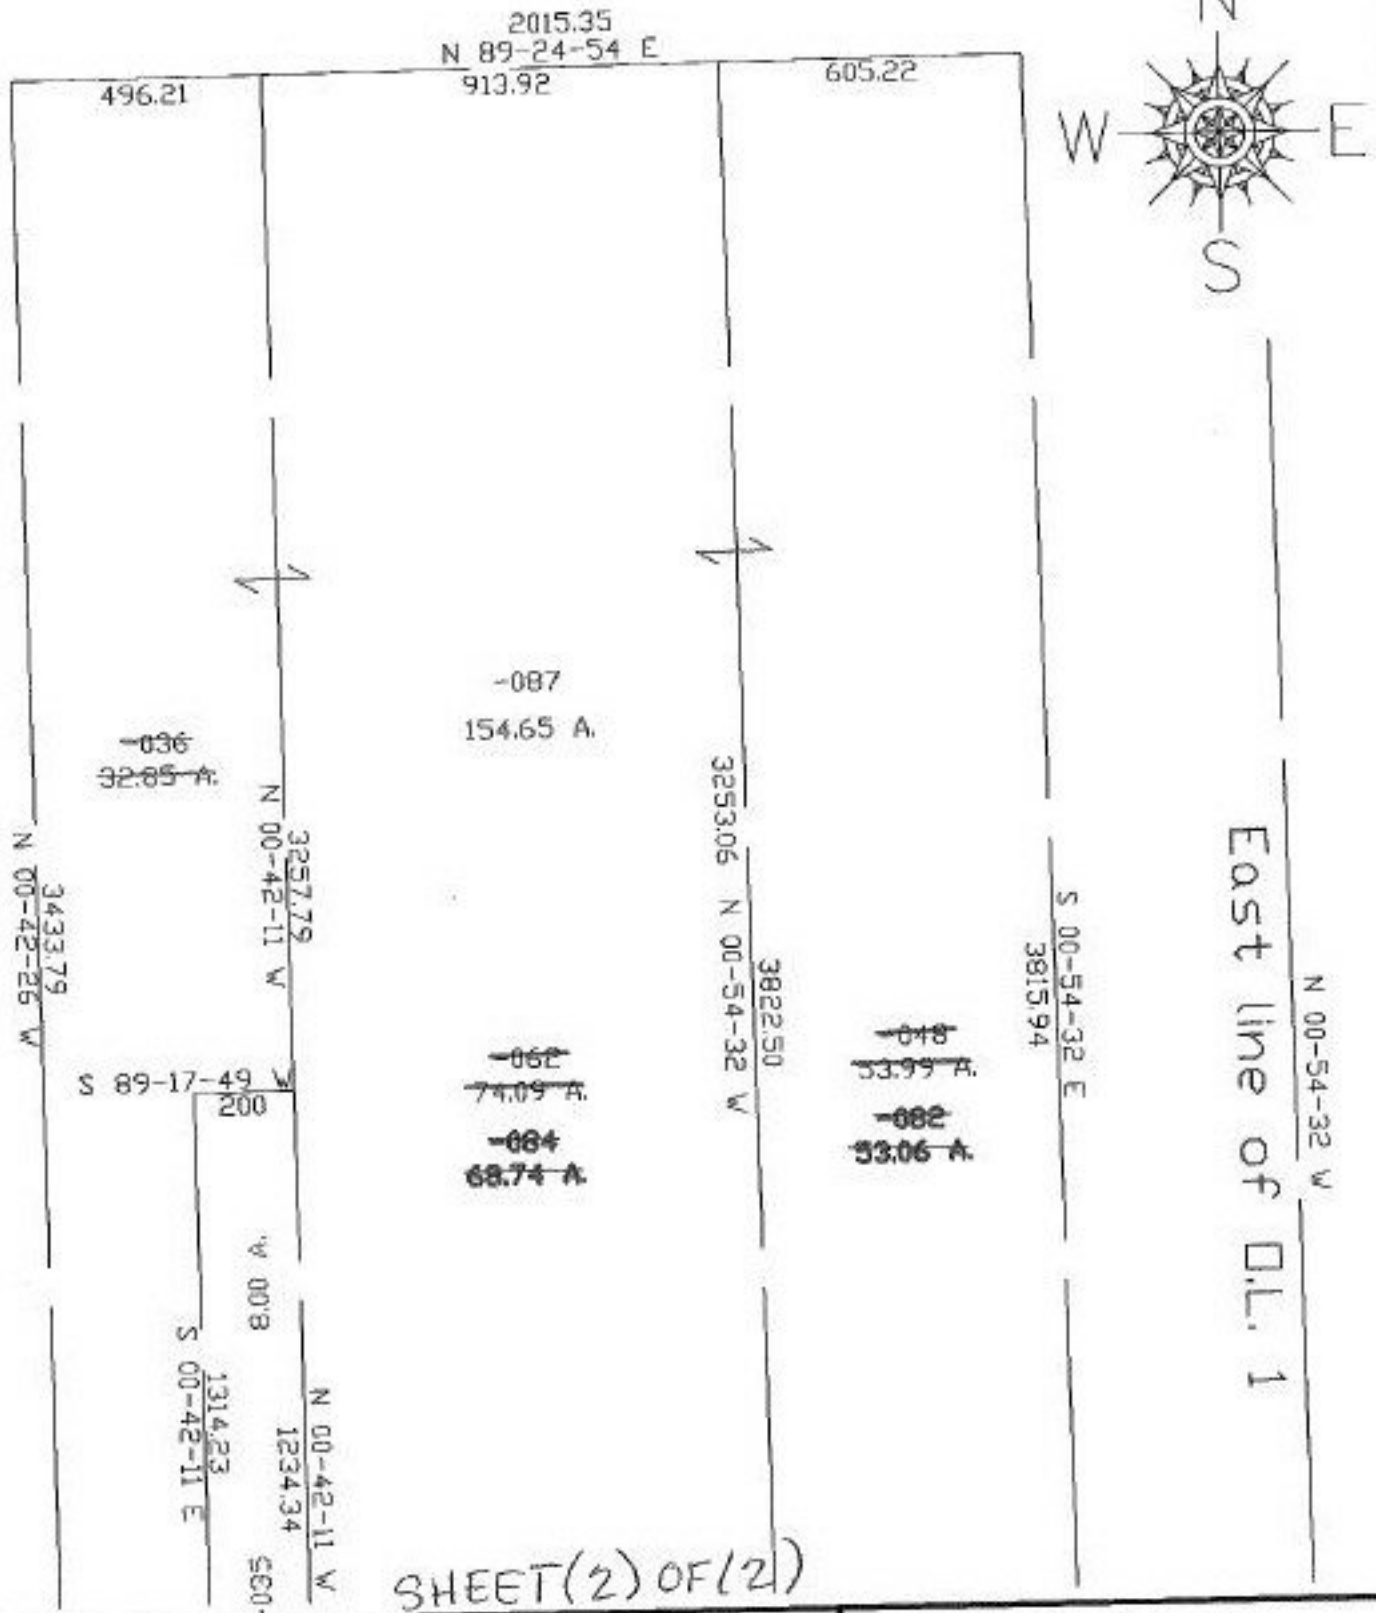

SPLITS/DEEDS PROCESSED
 LORAIN COUNTY TAX MAP DEPARTMENT
 226 MIDDLE AVE. ELYRIA, OHIO

SURVEYED BY: Richard Roy Mackay
 CLOSURE: 0.07:10.000
 MAP PAGE(S): 7-H, 7-00-001-C
 APPROVED BY: kac DATE:
 SCALE: 1" = 400 PRIOR INSTRUMENT: OR 1193/258