




(Handwritten initials)

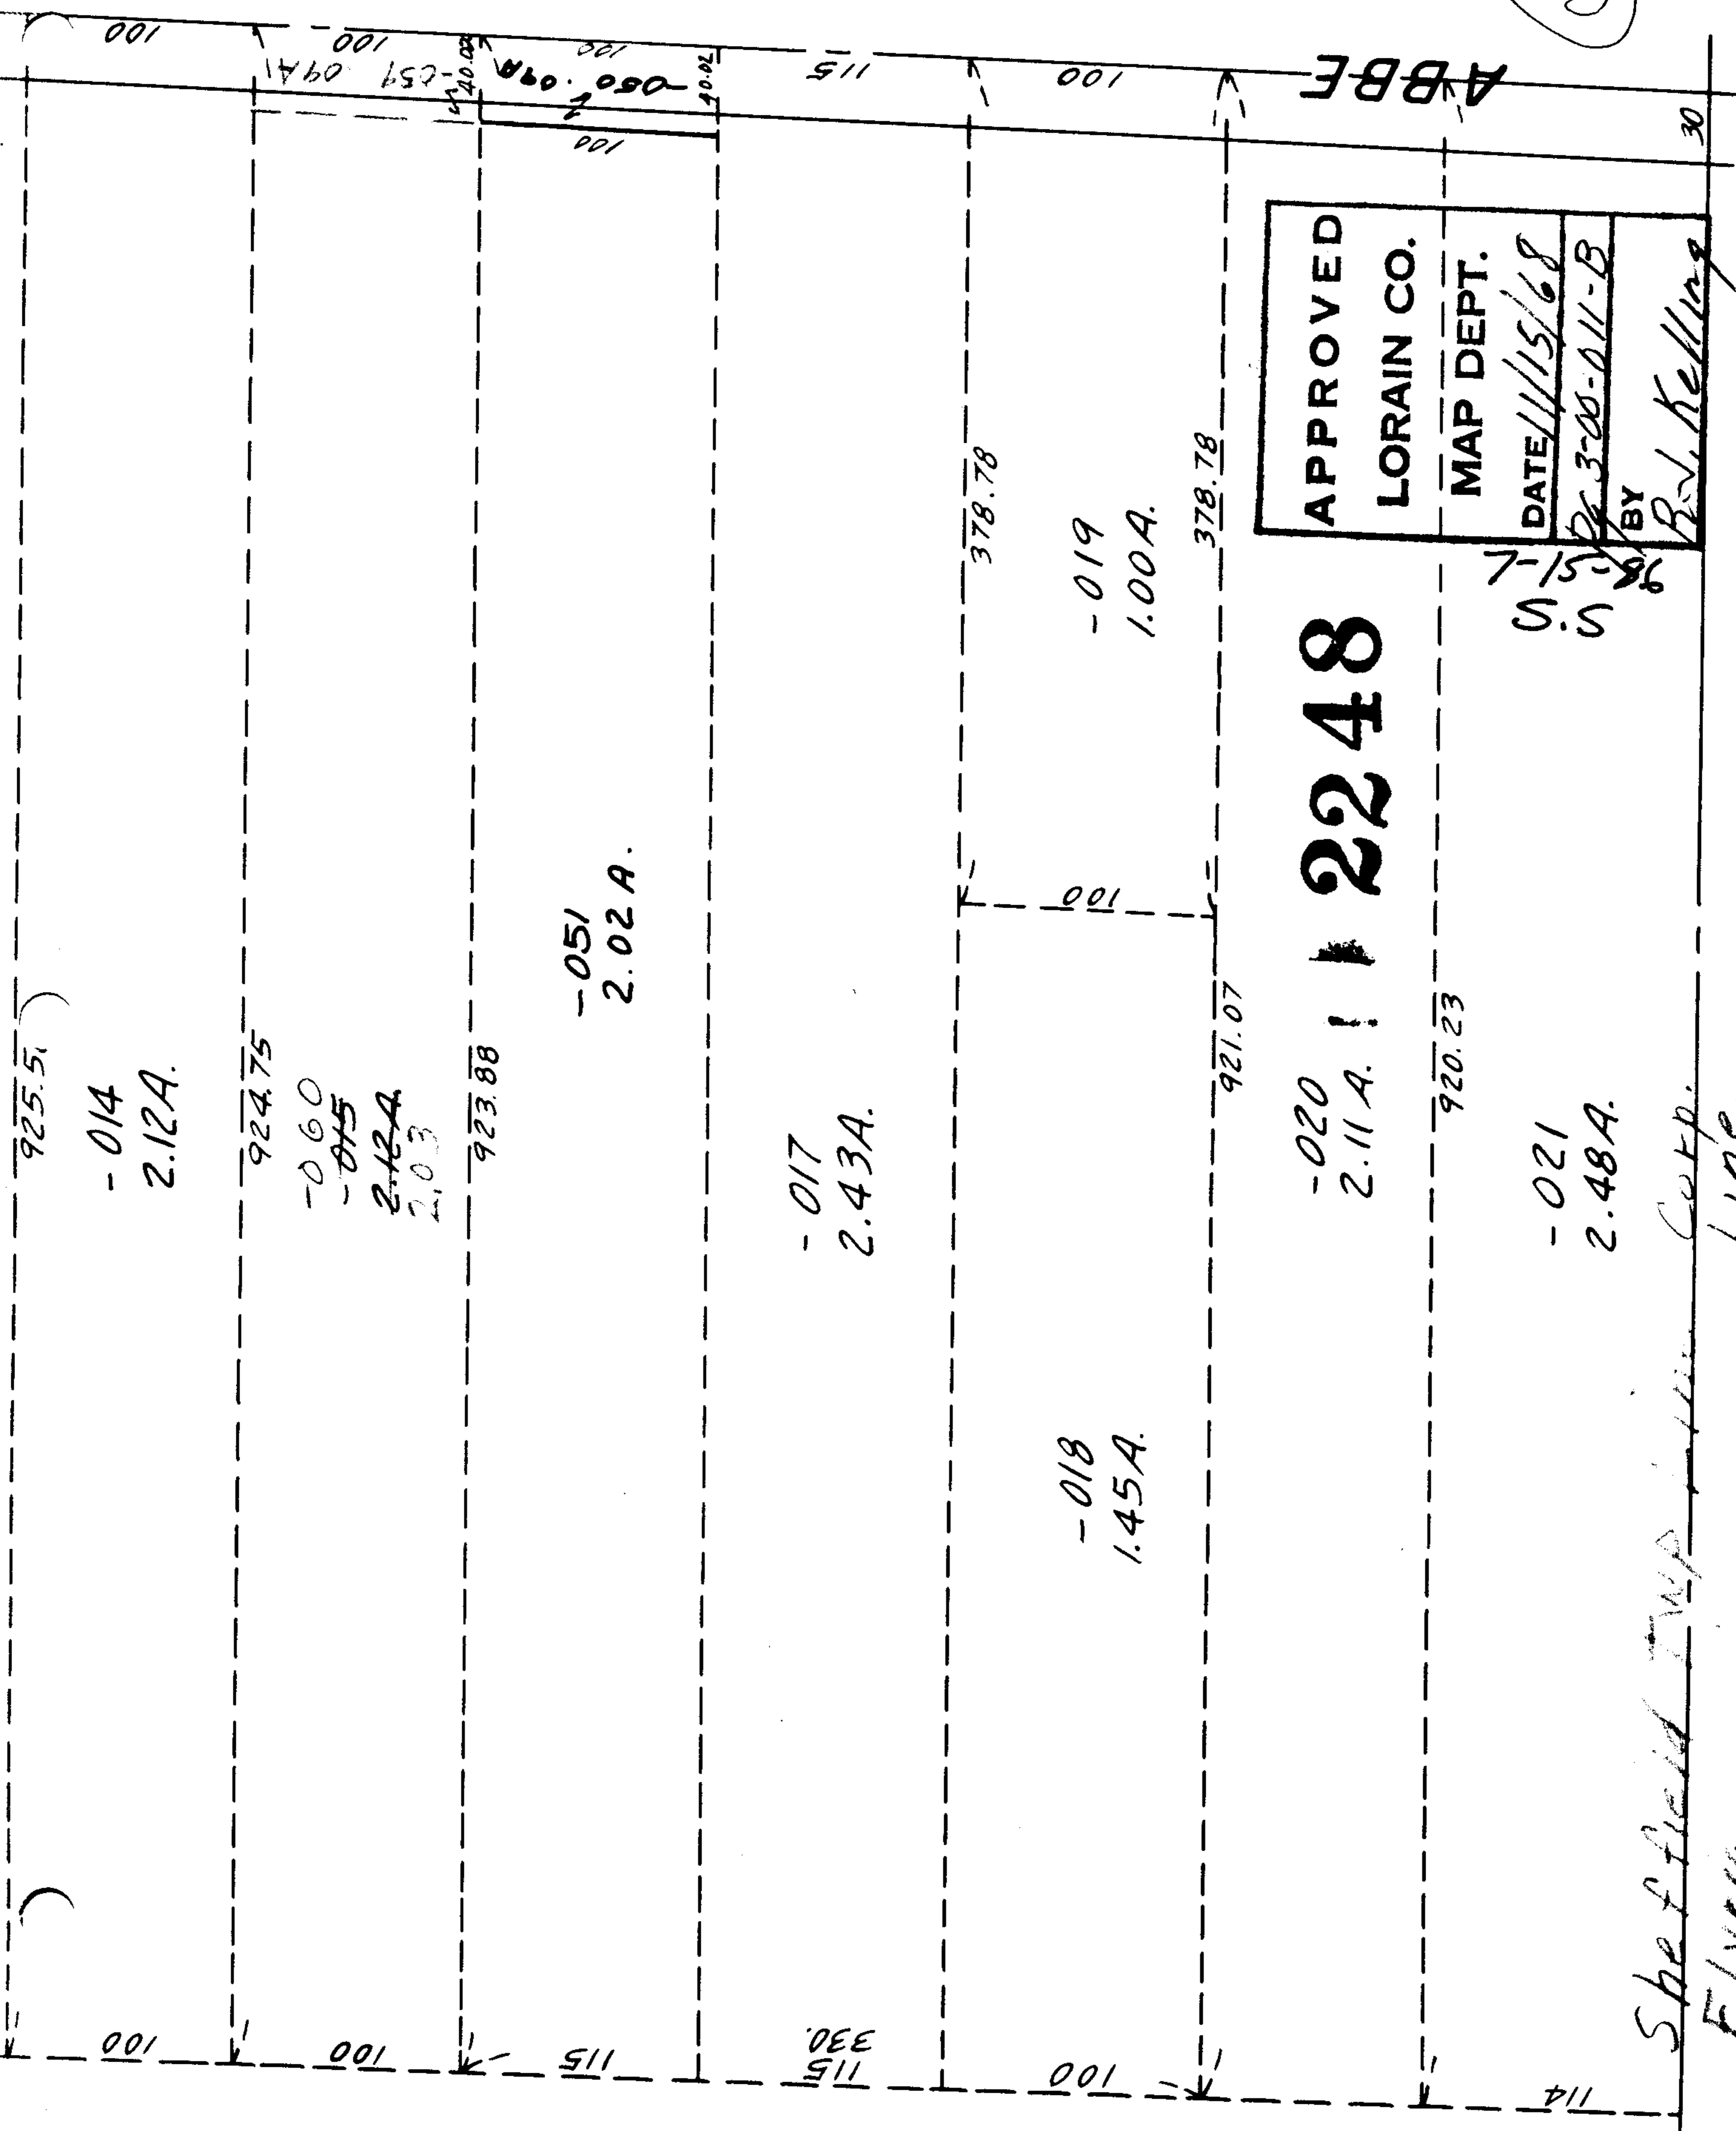

APPROVED
LORAIN CO.
MAP DEPT.
DATE 11/15/68
BY R. J. Kelling

2248

Sheffield Twp. Lin. Corp.
Elyria
LINGSEE 6-16

7-15-86
S.S.