


#22483
NO. 22483

PARENT PARCEL: 12-00-013-000-008
CHILD PARCEL: 12-00-013-000-038 & 039
STARTING POINT: NW CORNER LOT NO. 13 & cl. OF S. BOONE RD.



SURVEYED BY: GEORGE A. HOFMANN
CLOSURE: 0.01:10,000
MAP PAGE(S): 12-00-013-A
APPROVED BY: TJS DATE: 03/24/98
SCALE: 1" = 300' PRIOR INSTRUMENT: 1361/59

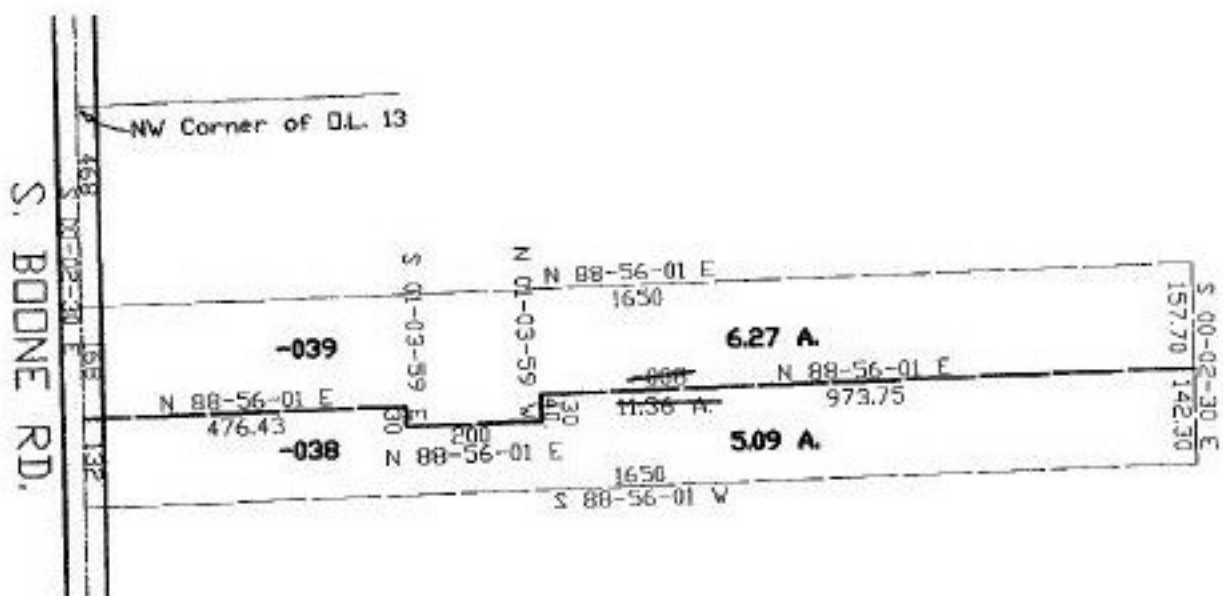

SPLITS/DEEDS PROCESSED
LORAIN COUNTY TAX MAP DEPARTMENT
226 MIDDLE AVE. ELYRIA, OHIO