


6-67

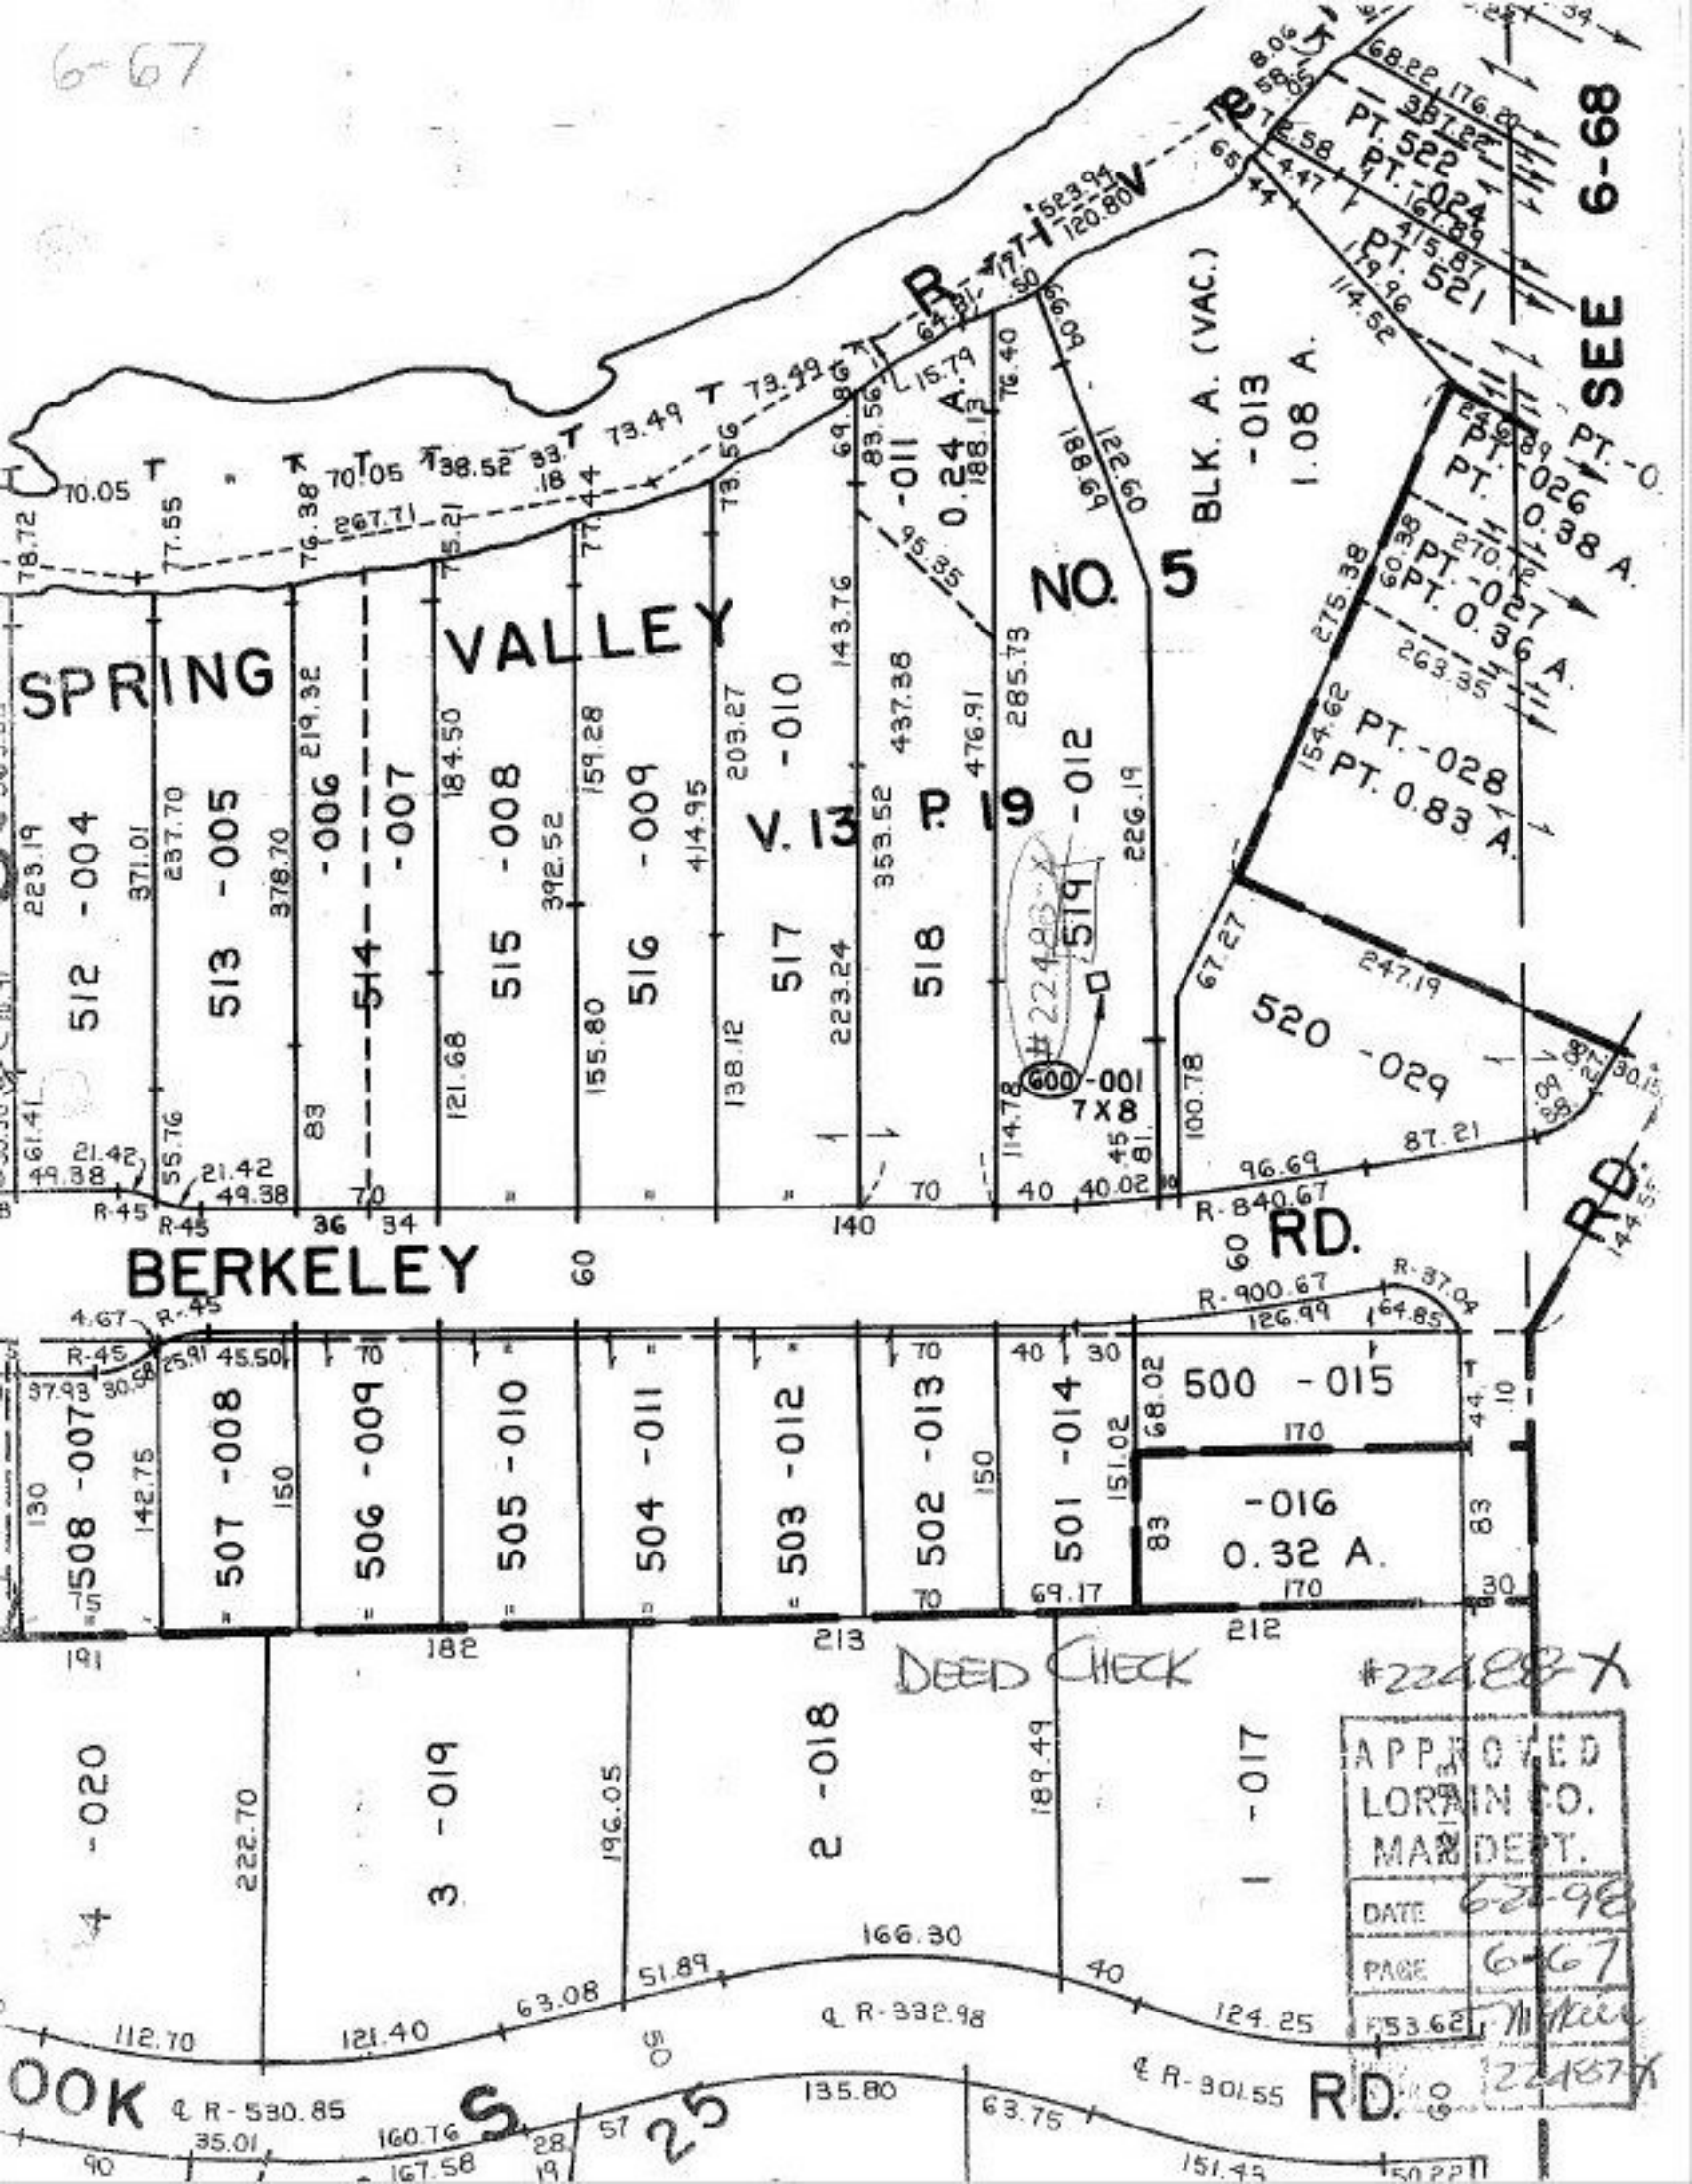

SPRING

VALLEY

NO. 5

BLK. A. (VAC.)

BERKELEY

RD.

RD.

SEE 6-68

512 - 004

513 - 005

514 - 006

515 - 008

516 - 009

517 - 010

518 - 011

519 - 012

520 - 029

PT. - 028
PT. 0.83 A.

PT. 522
PT. 024
PT. 521
PT. 026
PT. 038 A.
PT. 037
PT. 036 A.
PT. 027
PT. 028
PT. 0.83 A.

508 - 007

507 - 008

506 - 009

505 - 010

504 - 011

503 - 012

502 - 013

501 - 014

500 - 015
- 016
0.32 A.

4 - 020

3 - 019

2 - 018

1 - 017

DEED CHECK

#22488 X

APPROVED
LORAIN CO.
MAND. DEPT.
DATE 6-2-98
PAGE 6-67
53.62
22487 X

OOK S

RD.

25