

SEE 4-00-020-C

2887.68 FROM + E
JAYCOX RD. & WAI

(550) TO Q

609.98	-	157.17	
- 40.14		412.07	+ 452.51
<hr/>			
569.54			650.42
520.00			
39.54			
- 39.54			
<hr/>			
0.00			

RD. 192.11

RD. 192.11

-482
0.38 A.

-239
0.34 A.

-483
4.46 A.

411.87'
412.07' DIMENSION CORRECTION



WEDGEWOOD

BLOCK "A"

ACACIA

QUAIL

HOLLIS

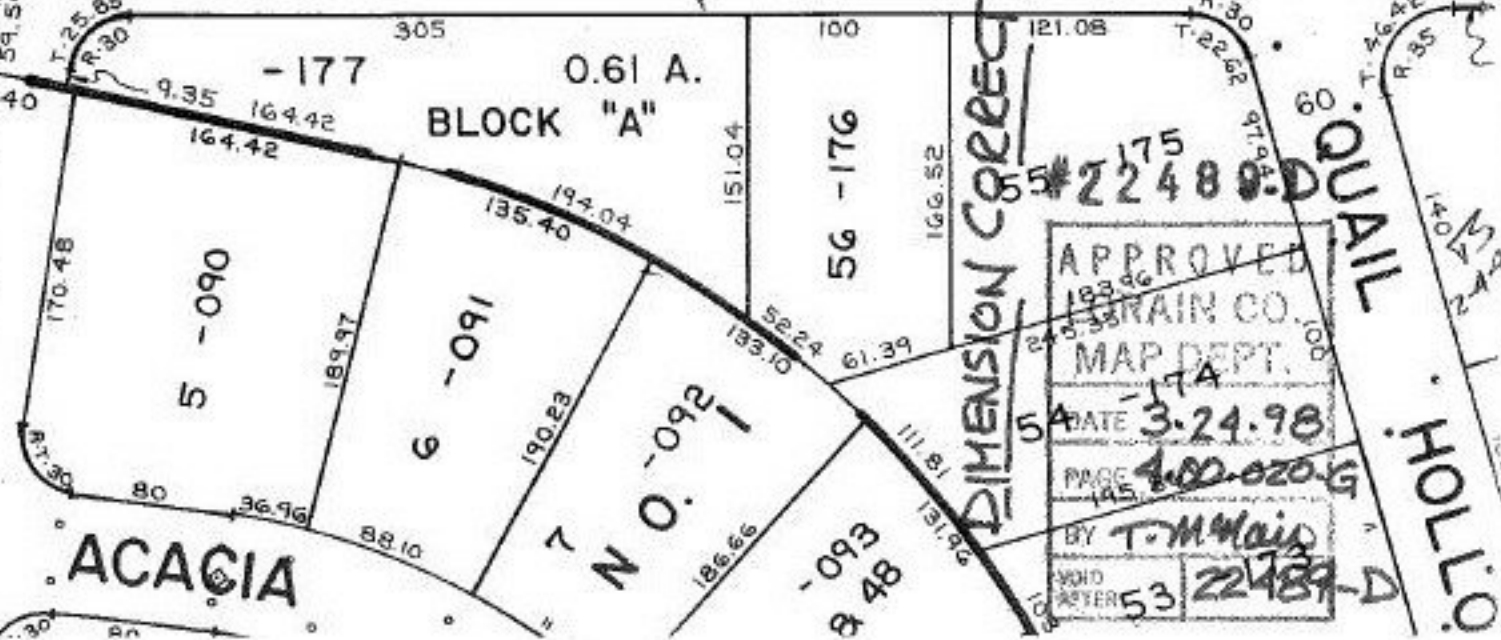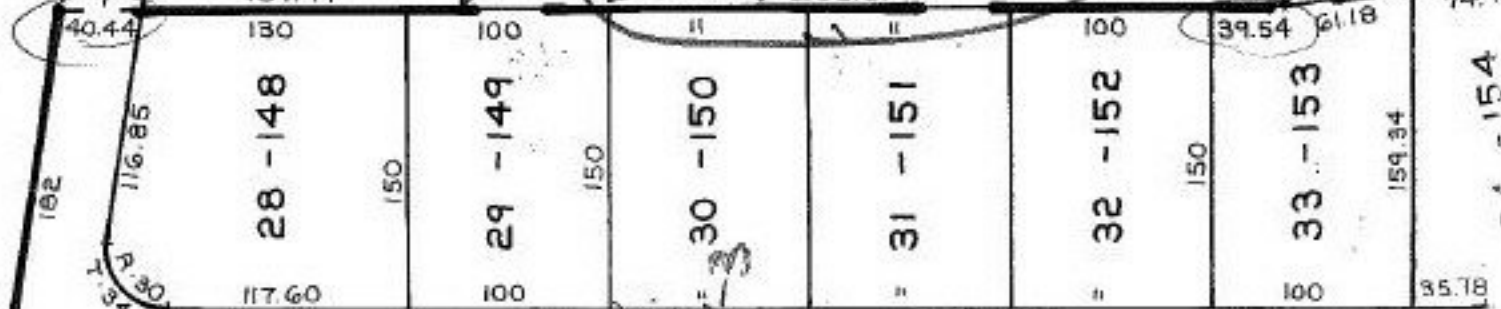

APPROVED
183.00
RAIN CO.
MAP DEPT.
DATE 3-24-98
PAGE 145
BY T. M. HAIN
VND REFER 53

75-20

76-24

FAIR

74-7

154

60

60

60

60

98.98

136.47

150.42

263.53

264.76

20

154

35.78

159.34

121.08

121.08

