


PARENT PARCEL: 09-00-012-000-030, 031
 CHILD PARCEL: 09-00-012-000-032, 033, 034
 STARTING POINT: c.l. of Russia Rd. & c.l. of Quarry Rd.

NO. 22489

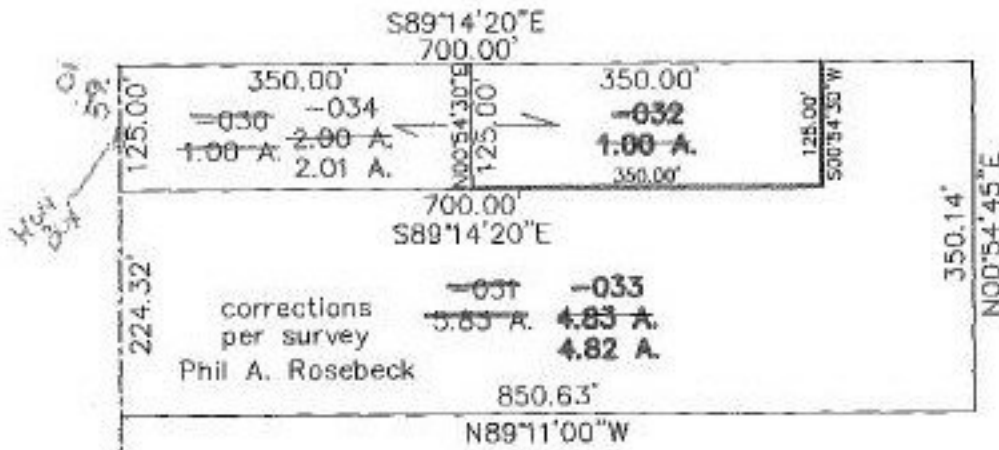

S00°54'30"W
1469.92'

Quarry Rd.

1120.60'

Russia Rd.

*1. P.M.
MOM
BOB*

*200.66
350
150.66*



SPLITS/DEEDS PROCESSED
 LORAIN COUNTY TAX MAP DEPARTMENT
 226 MIDDLE AVE. ELYRIA, OHIO

SURVEYED BY: Phil A. Rosebeck
 CLOSURE: 0.00; 10.000
 MAP PAGE(S): 09-00-012-A
 APPROVED BY: kac DATE: 3/31/98
 SCALE: 1" = 200' PRIOR INSTRUMENT: OR 419/137

fw 6/2/99