

#22491

NO. 22491


PARENT PARCEL: 06-25-001-000-082, 07-00-048-000-007, 10-00-005-102-313
11-00-091-000-002, 003, 004, 005, 019, 021, 11-00-092-000-002, 063

CHILD PARCEL: 11-00-091-000-020, 021, 022

STARTING POINT: c. of Dewhurst Rd. & c. of Chestnut Ridge Rd.



Block A 86.34 A.		Block B 52.06 A.	
06-25-001-000-082	5.96	Pt. of 11-00-091-000-002	42.37
07-00-048-000-007	10.01	Pt. of 11-00-091-000-003	45.07
10-00-005-102-313	1.38	11-00-091-000-004	2.07
Pt. of 11-00-091-000-002	42.37	11-00-091-000-019	9.74
Pt. of 11-00-091-000-003	45.07	11-00-092-000-002	1.00
11-00-091-000-005	51.61	11-00-092-000-003	0.42
11-00-091-000-020	68.99	11-00-091-000-021	40.06
Total: 86.34		Total: 52.06	

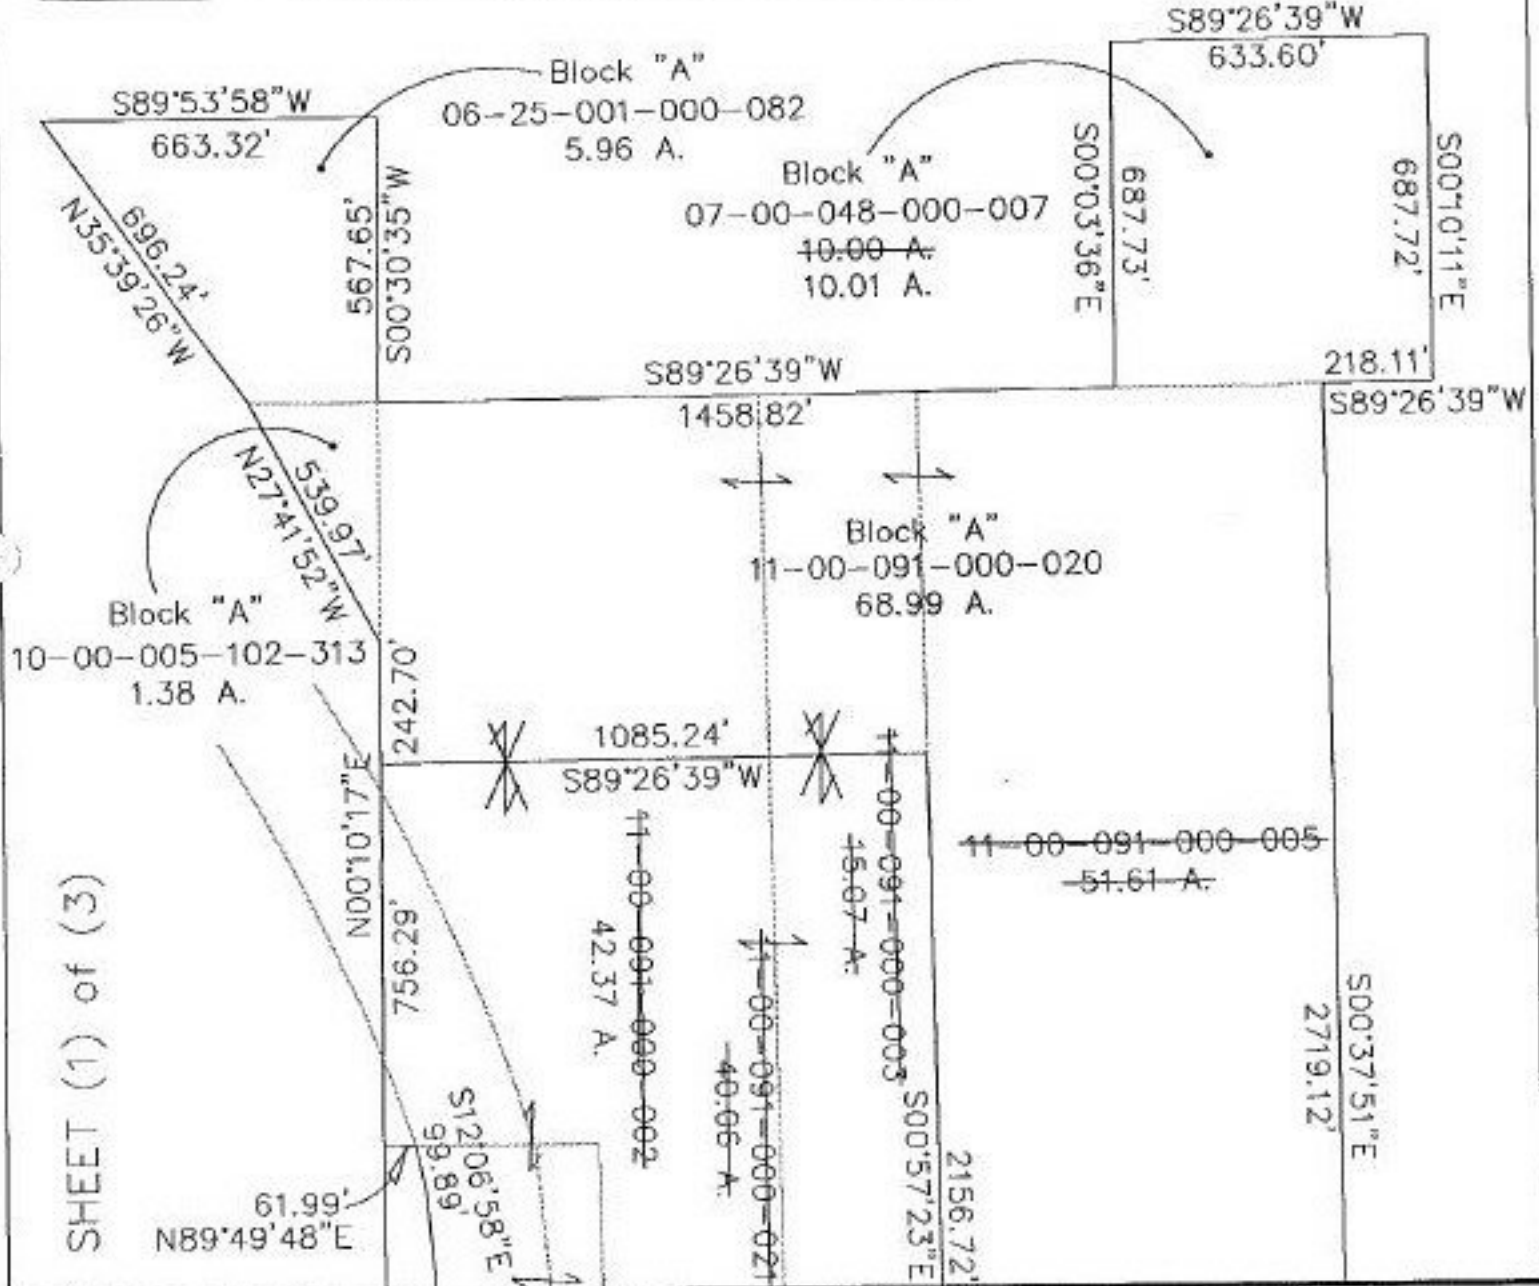

SHEET (1) of (3)



SPLITS/DEEDS PROCESSED
LORAIN COUNTY TAX MAP DEPARTMENT
226 MIDDLE AVE. ELYRIA, OHIO

SURVEYED BY: Terin Kominski
MAP PAGE(S): 6-144, 7-E, 10-00-005-D,
11-A, 11-00-092-A
APPROVED BY: kac DATE: 3/19/98
SCALE: 1" = 400' PRIOR INSTRUMENT: