

PARENT PARCEL: 16-00-002-105-020

CHILD PARCEL: N/A


STARTING POINT: cl. of Chestnut St. & NE line of land conveyed to Frank Bladowski

NO. 22498-D



-020  
~~66 X 135~~  
66 X 165

Depth Correction  
per deed  
OR 549/819

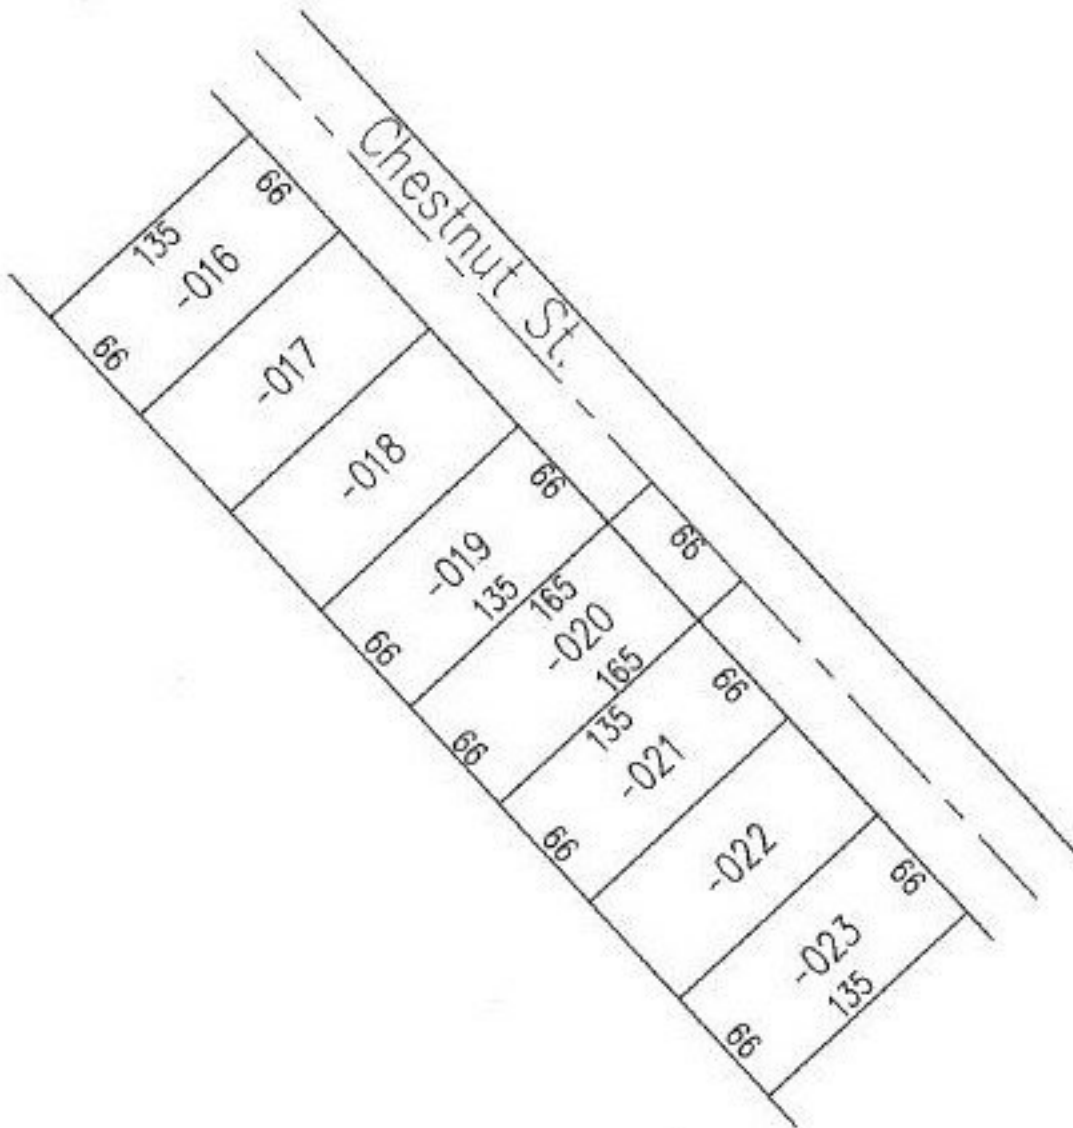

*42189  
m.B.*



**SPLITS/DEEDS PROCESSED**  
LORAIN COUNTY TAX MAP DEPARTMENT  
226 MIDDLE AVE. ELYRIA, OHIO

SURVEYED BY: \_\_\_\_\_  
CLOSURE: cannot run  
MAP PAGE(S): 16-00-001-D  
APPROVED BY: kac DATE: 4/20/98  
SCALE: 1" = 100' PRIOR INSTRUMENT: OR 549/819