
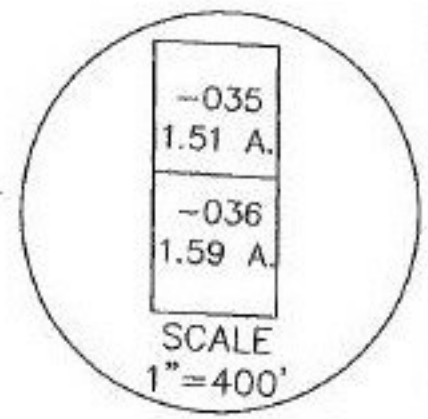


PARENT PARCEL: 20-20-009-000-032

CHILD PARCEL: 20-20-009-000-035, 036

STARTING POINT: cl. of Gore-Orphanage Rd. & cl. of New London-Eastern Rd.

NO. 22499

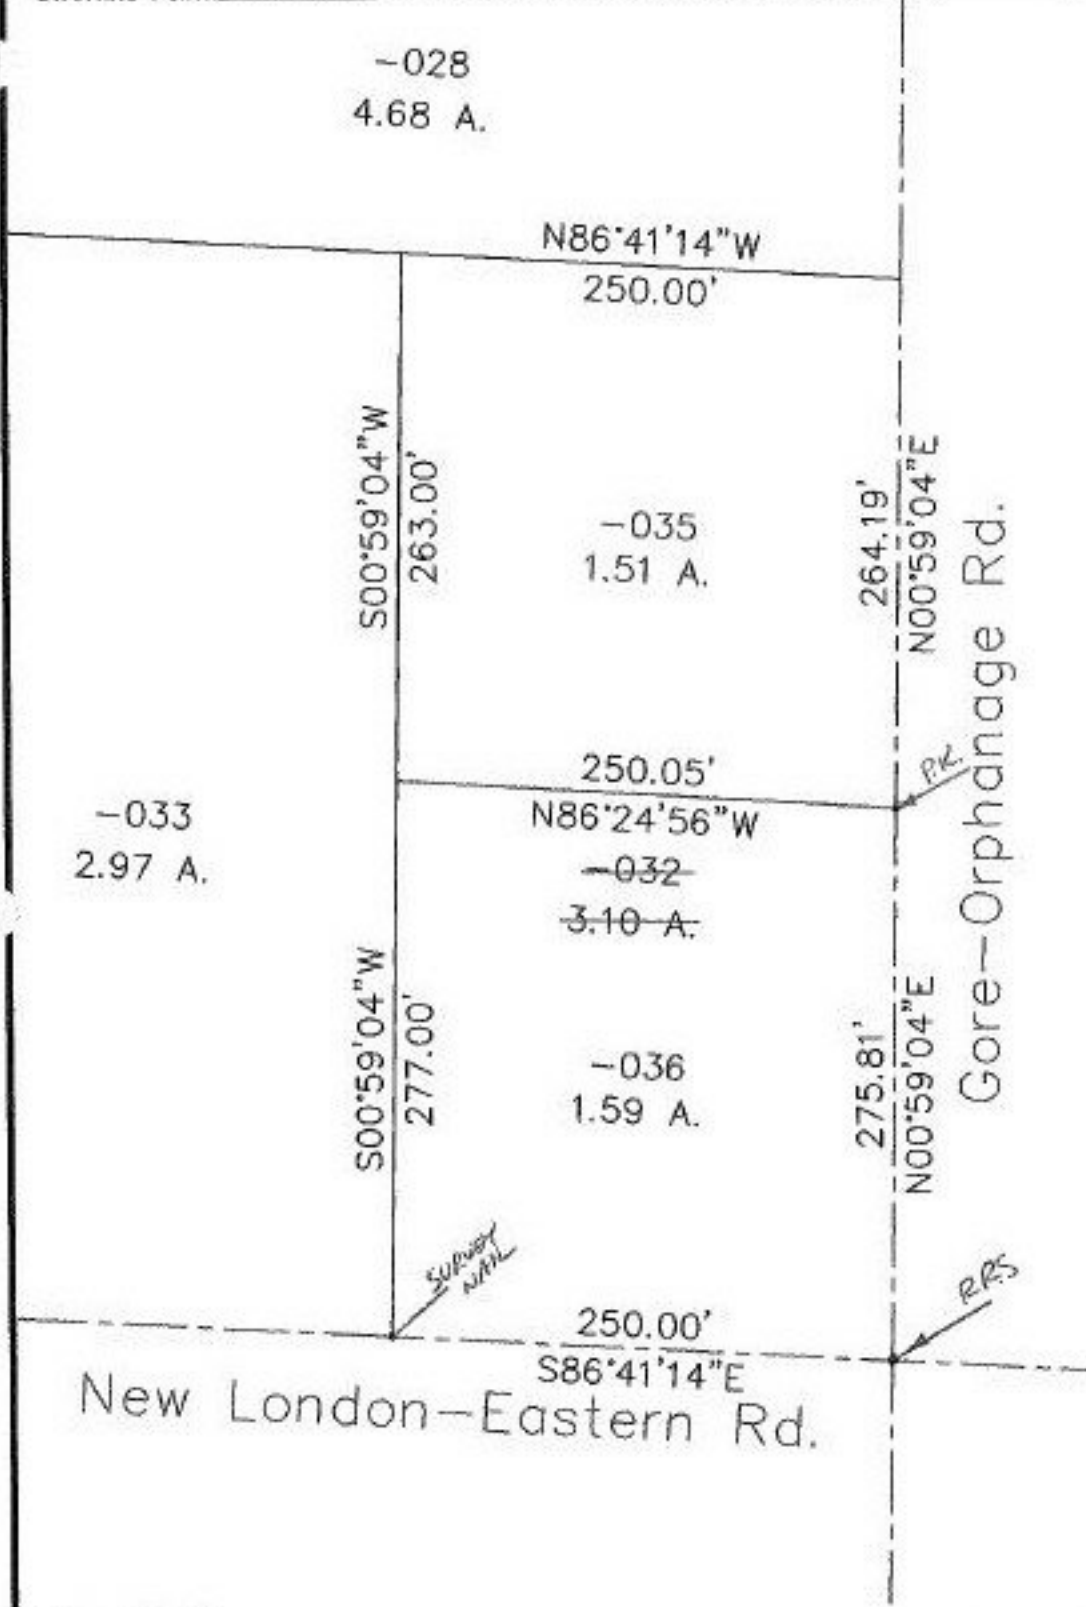

DP 7-6-79



SPLITS/DEEDS PROCESSED
LORAIN COUNTY TAX MAP DEPARTMENT
 226 MIDDLE AVE. ELYRIA, OHIO

SURVEYED BY: William Lee Spencer
 CLOSURE: 0.04:10,000
 MAP PAGE(S): 20-F
 APPROVED BY: kac DATE: 4/14/98
 SCALE: 1"= 100 PRIOR INSTRUMENT: OR 1421/238