


SEE 21-06-000-A

NEW LONDON - LAFAYETTE

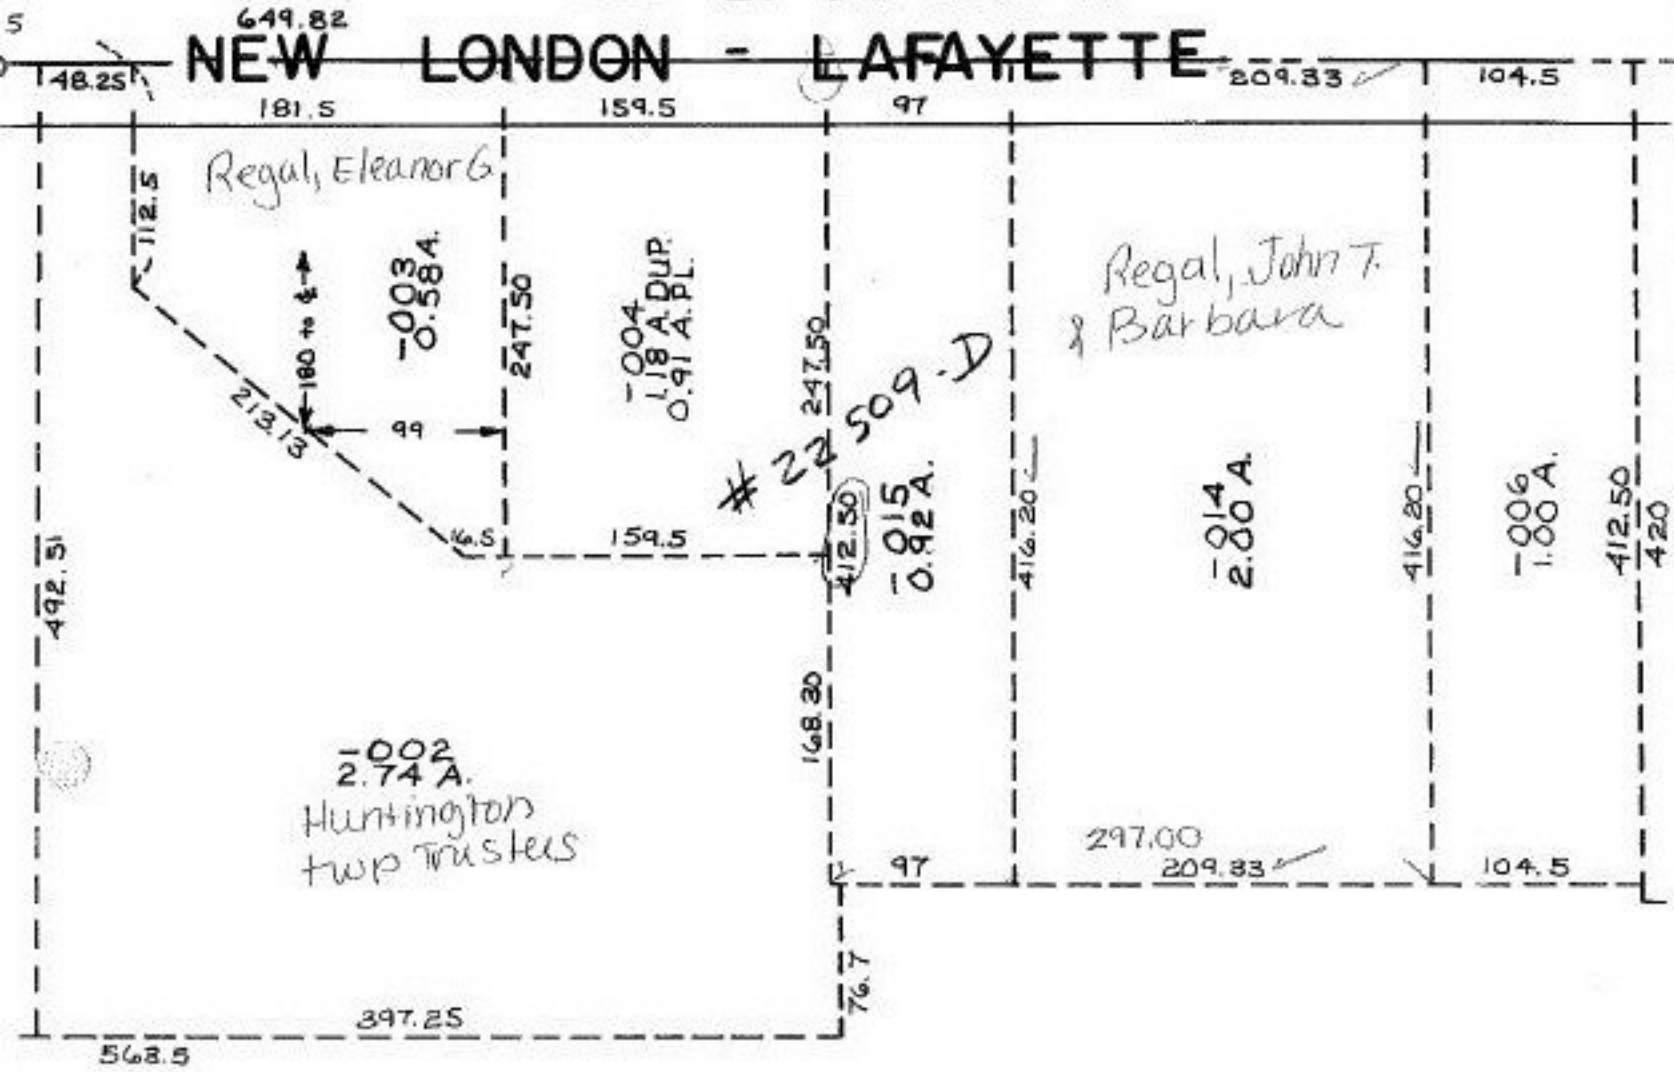

Pt. -008
Pt. 32.59A