


#22510

NO. 22510

PARENT PARCEL: 01-00-053-000-034

CHILD PARCEL: 01-00-053-000-035, 036

STARTING POINT: cl. of Claus Rd. & SW corner of Angersbach's Claus Rd. Subdivision

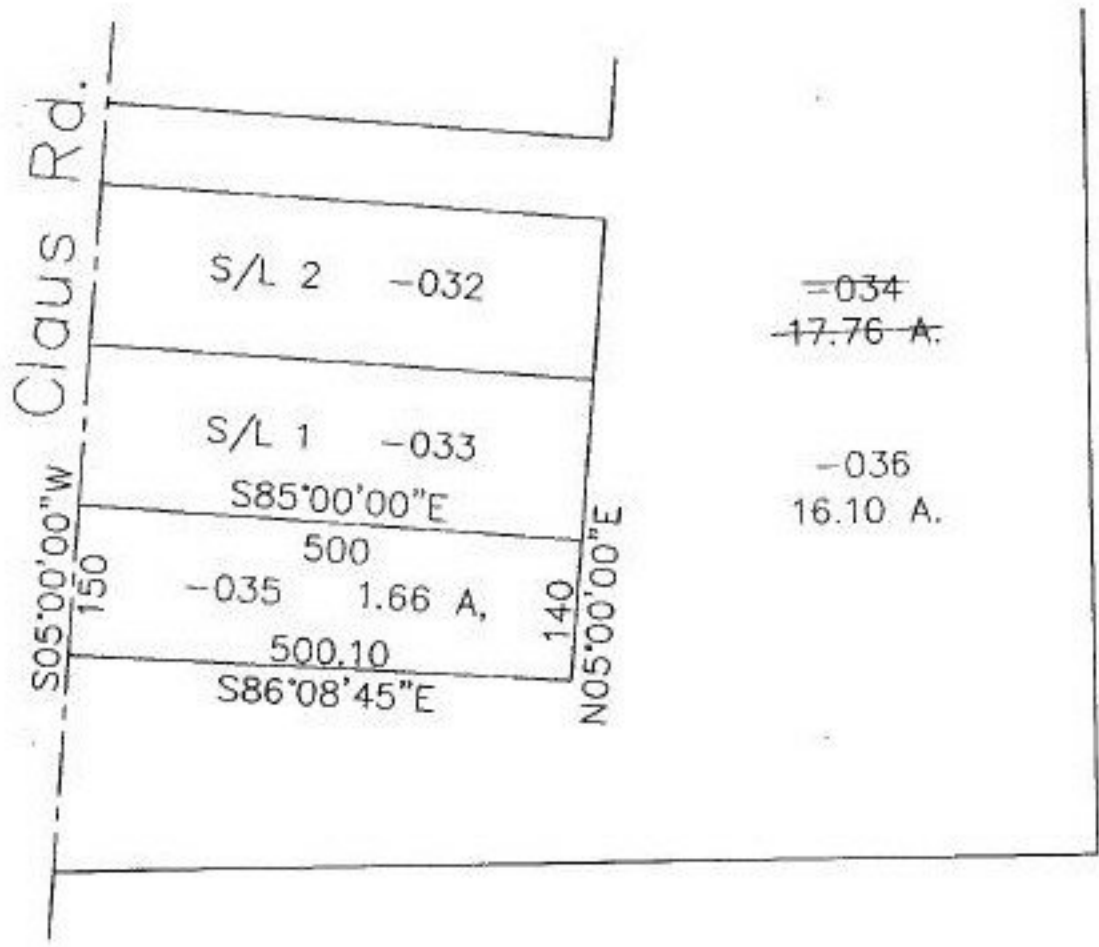

SPLITS/DEEDS PROCESSED
 LORAIN COUNTY TAX MAP DEPARTMENT
 226 MIDDLE AVE. ELYRIA, OHIO

SURVEYED BY: M.G. Hura
 CLOSURE: 0.00:10.000
 MAP PAGE(S): 01-00-053-B
 APPROVED BY: kac DATE: 5/12/98
 SCALE: 1" = 200' PRIOR INSTRUMENT: OR 785/509