


SEE

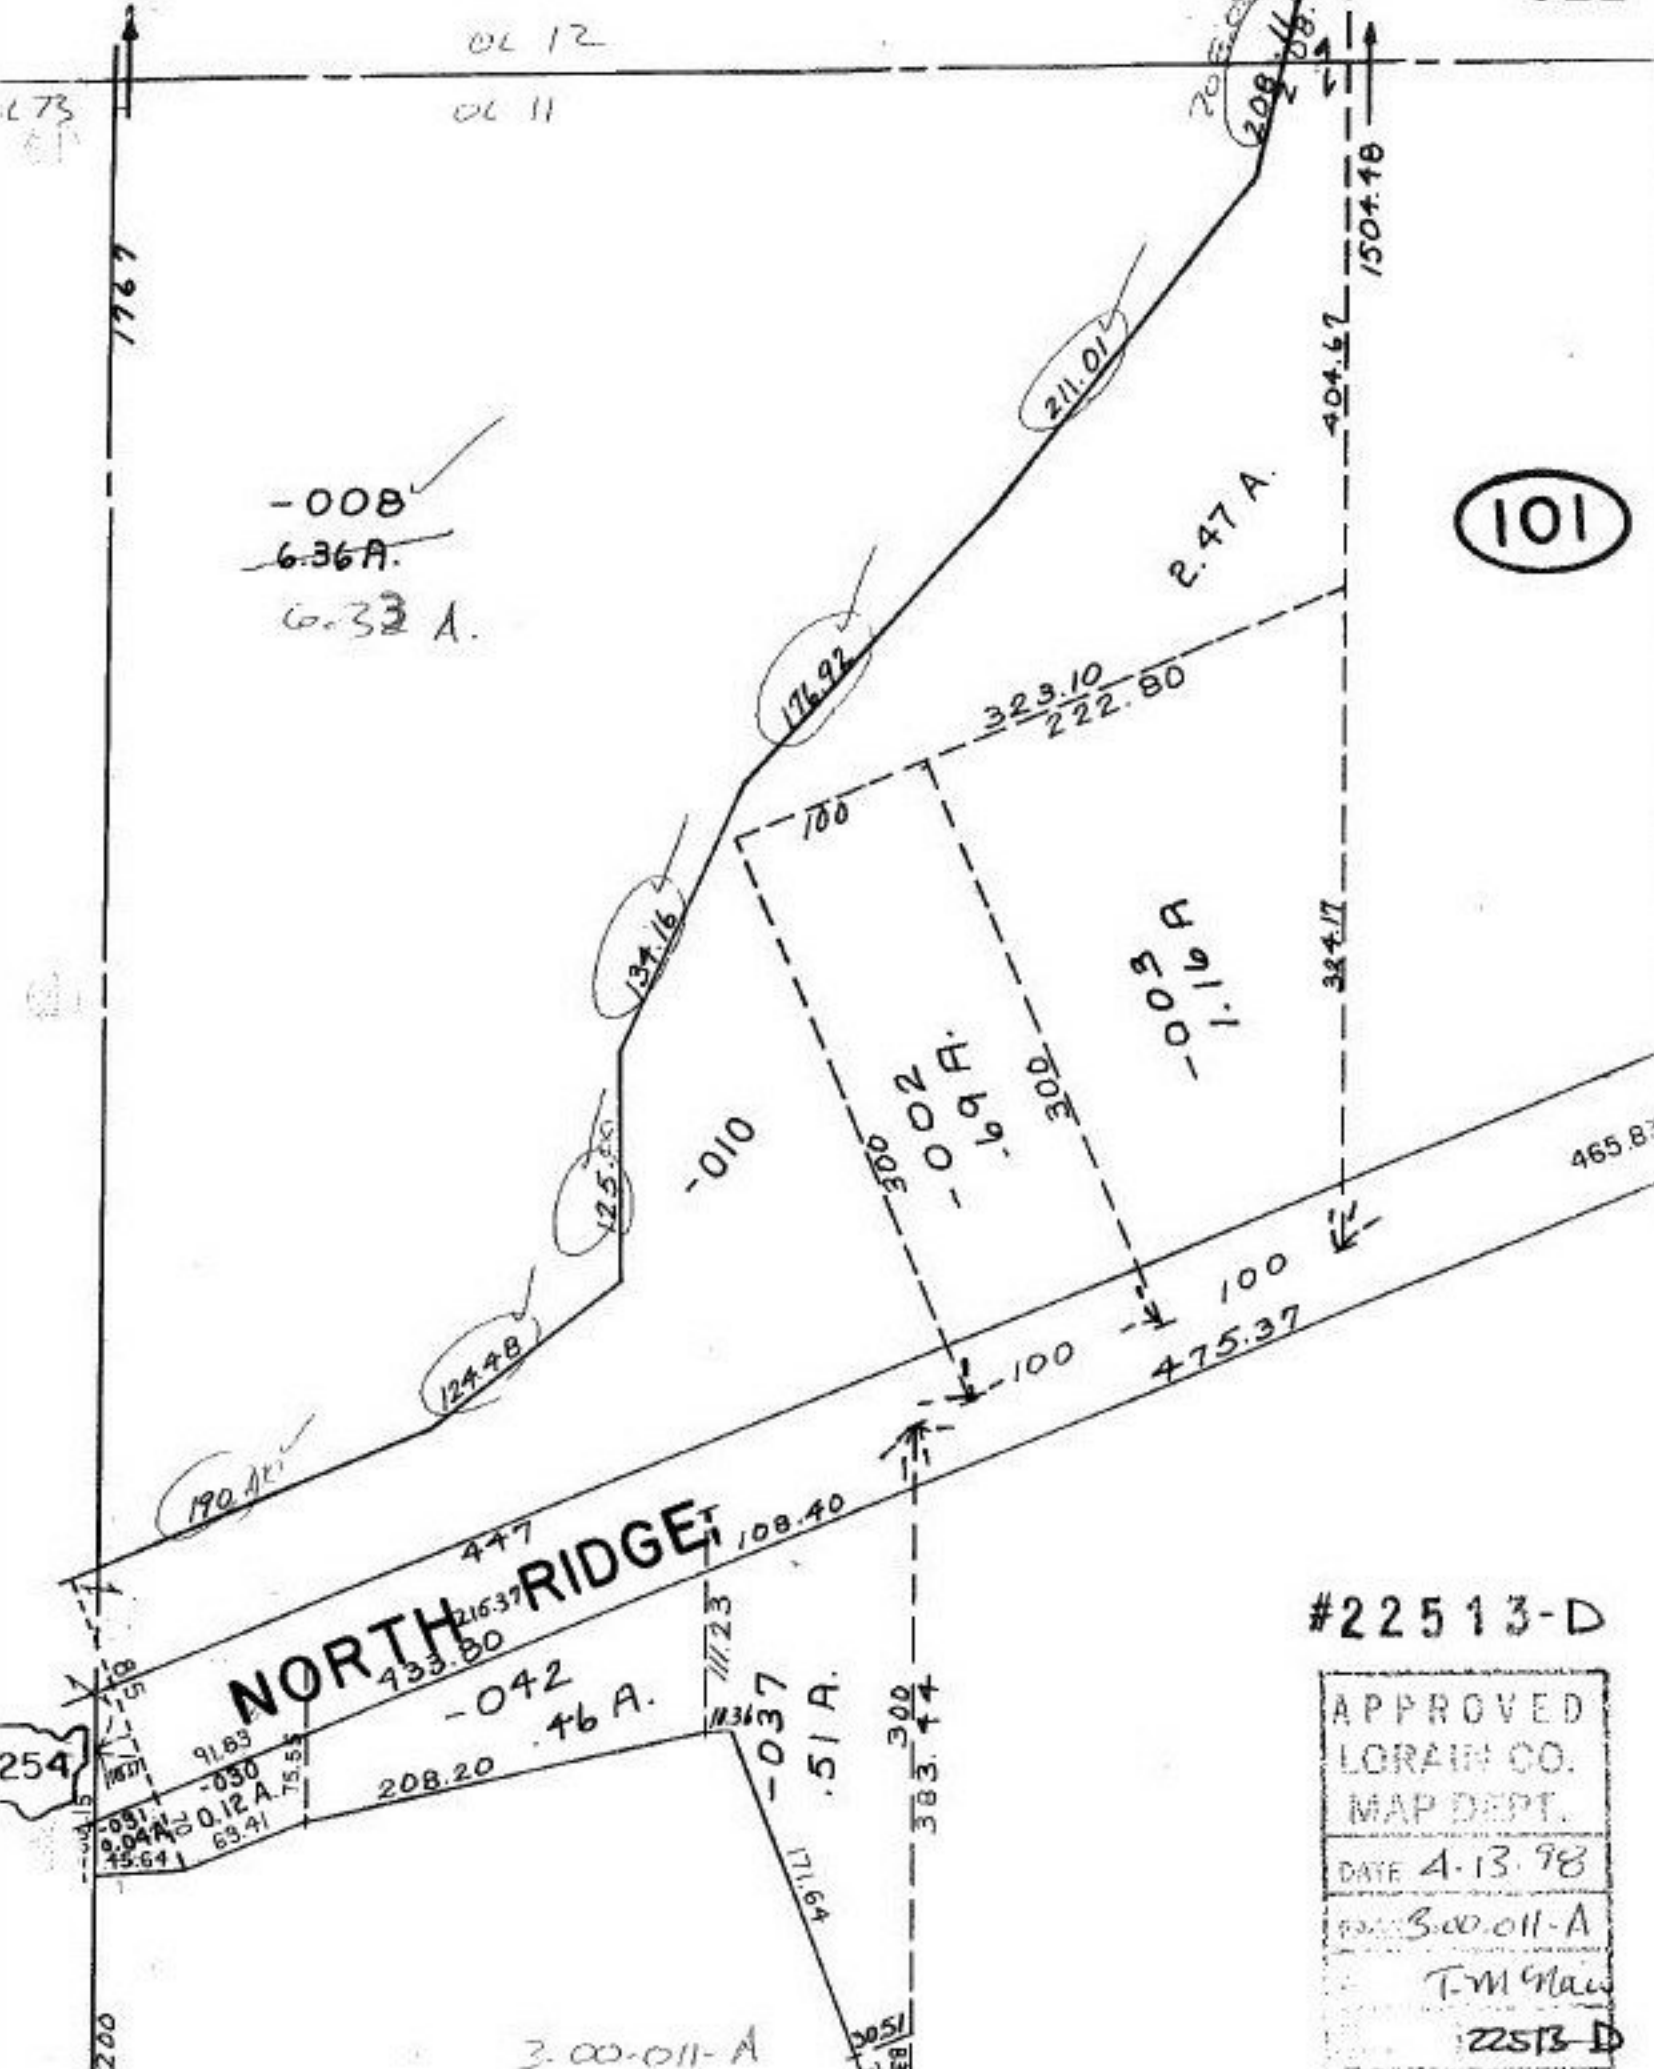

101

NORTH RIDGE

#22513-D

APPROVED  
 LORAIN CO.  
 MAP DEPT.  
 DATE 4-13-98  
 3.00-011-A  
 T.M. Galt  
 22513-D

254

3.00-011-A