

#22513-D

O.L. 73

O.L. 11

-008

~~6.36 A.~~

6.33 A.

~~=023~~

~~6.97 A.~~

corr. per surv.  
David L. Elwell

S02°39'34"W

1005.39'


-063

~~7.66 A.~~

7.54 A.

134.16'

190.00' 124.48' 125

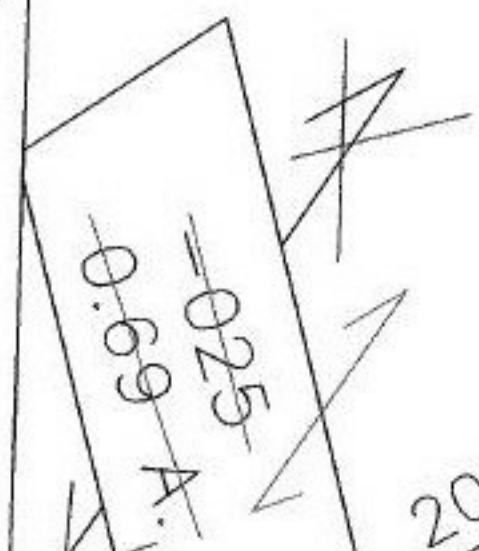

206.57'

N 13° 10' 31" W  
55

392.00'  
S69°40'29"W

S69°00'

North Ridge R.