


PARENT PARCEL: 15-00-055-101-001

CHILD PARCEL: SAME

STARTING POINT: NW corner of O.L. 55


NO. 22516-X

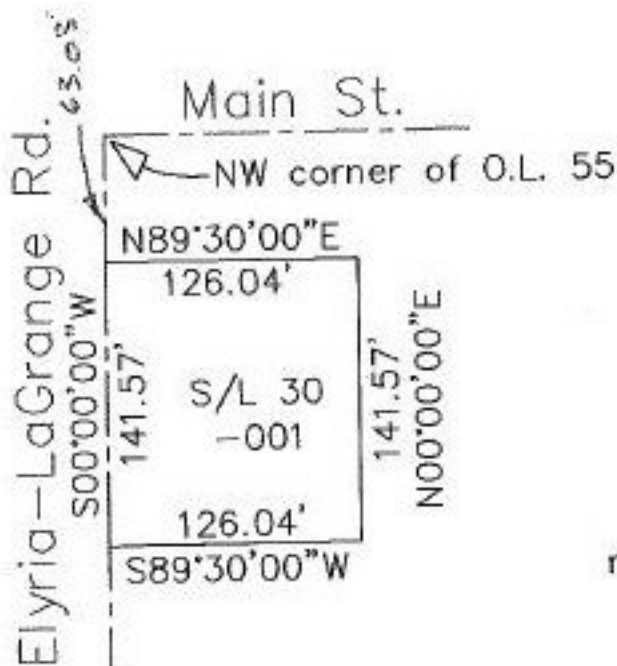

Need to correct:
register and duplicate

-001
~~128.04 X 142~~
126.04 X 141.57
corr. per deed
OR 1172/884

*4-21-99
m.B.*

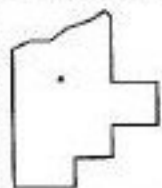

SPLITS/DEEDS PROCESSED
LORAIN COUNTY TAX MAP DEPARTMENT
226 MIDDLE AVE. ELYRIA, OHIO

SURVEYED BY: J.W. Warden & Assoc.
CLOSURE: 0.00:10.000
MAP PAGE(S): 15-00-055-A
APPROVED BY: kac DATE: 5/4/98
SCALE: 1"=100 PRIOR INSTRUMENT: OR 1172/884