


PARENT PARCEL: 20-05-009-000-006

CHILD PARCEL: 20-05-015-000-005, 20-05-009-000-033

STARTING POINT: CL OF BURSLEY RD.

NO. 22516

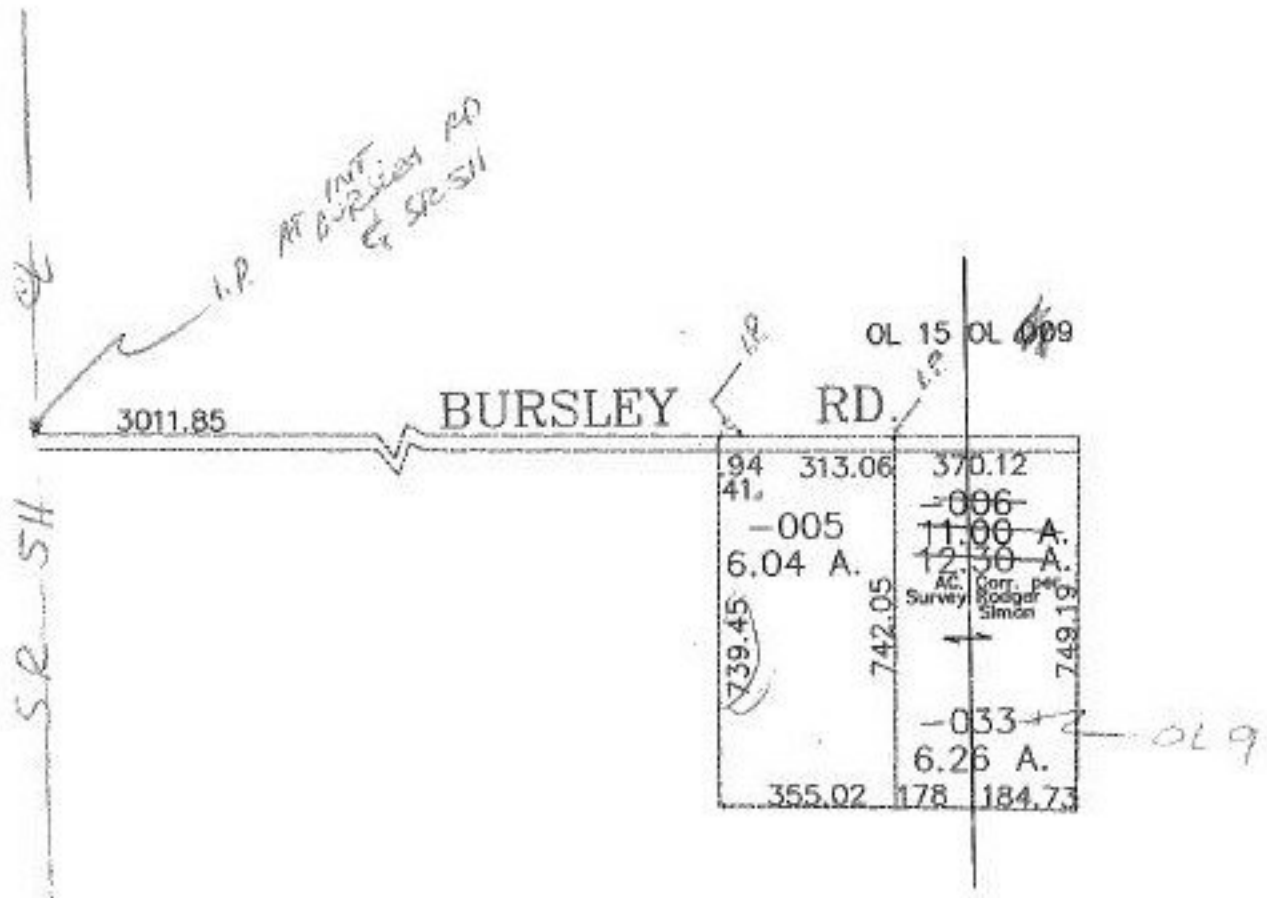

DN 1 6-30



**SPLITS/DEEDS PROCESSED**  
 LORAIN COUNTY TAX MAP DEPARTMENT  
 226 MIDDLE AVE. ELYRIA, OHIO

SURVEYED BY: RODGER G. SIMON  
 CLOSURE: 0.01 : 10.000  
 MAP PAGE(S): 20-C, 20-D  
 APPROVED BY: JAH DATE: 6-15-98  
 SCALE: 1" = 400' PRIOR INSTRUMENT: DV 1011/998