


PARENT PARCEL: 17-07-006-000-023

CHILD PARCEL: 17-07-006-000-024, 025


STARTING POINT: c.l. of Norwalk-Medina Rd. & c.l. of Gore-Orphanage Rd.

NO. 22518

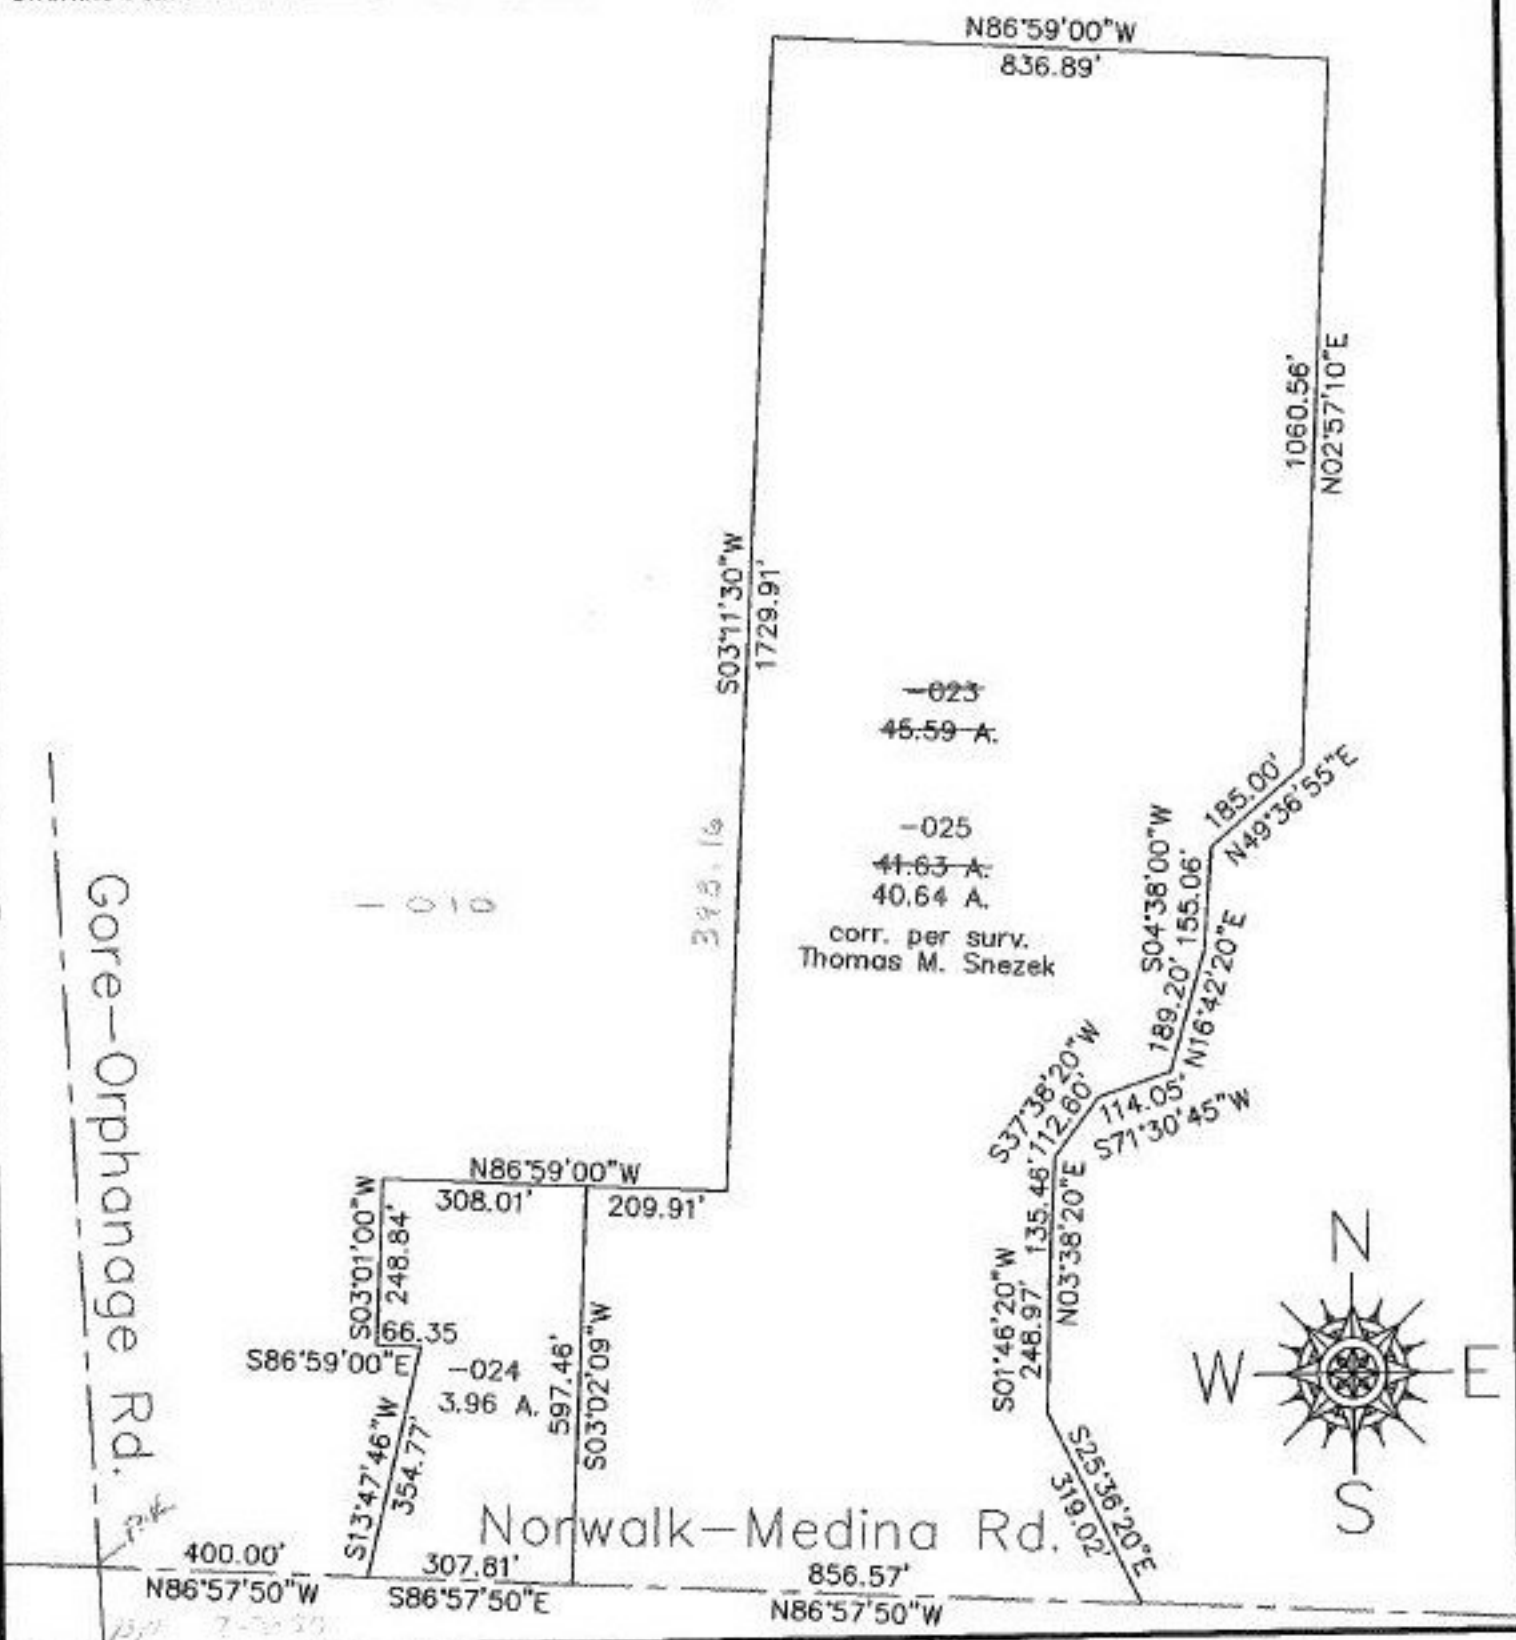

Gore-Orphanage Rd.

Norwalk-Medina Rd.

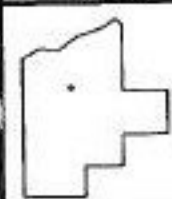

SPLITS/DEEDS PROCESSED
LORAIN COUNTY TAX MAP DEPARTMENT
 226 MIDDLE AVE. ELYRIA, OHIO

SURVEYED BY: Thomas M. Snezek
 CLOSURE: 0.03:10.000
 MAP PAGE(S): 17-A
 APPROVED BY: kac DATE: 5/5/98
 SCALE: 1" = 300' PRIOR INSTRUMENT: OR 1137/419