

PARENT PARCEL: 03-00-030-102-006


CHILD PARCEL: 03-00-030-102-009 thru -013

STARTING POINT: c.l. of Lake Breeze Rd. & c.l. of South Ave.

NO. 22519



N89°58'00"W South Ave. N89°58'00"W 30'

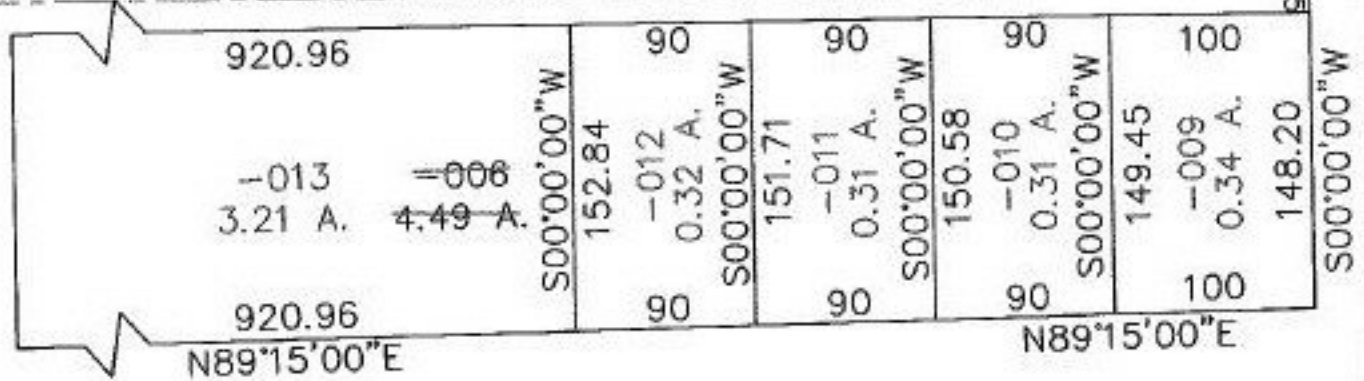

Lake Breeze Rd.

*Void*  
*11/9/98*



**SPLITS/DEEDS PROCESSED**  
LORAIN COUNTY TAX MAP DEPARTMENT  
226 MIDDLE AVE. ELYRIA, OHIO

SURVEYED BY: John Pozywak  
CLOSURE: XXXXXX  
MAP PAGE(S): 03-00-030-A  
APPROVED BY: kac DATE: 5/12/98  
SCALE: 1" = 100' PRIOR INSTRUMENT: \_\_\_\_\_