

PARENT PARCEL: 11-00-057-000-061


NO. 22519-X

CHILD PARCEL:

STARTING POINT: cl. of Capel Rd. & cl. of Avon Belden Rd.

CORRECTIONS

FIX TWO DISTANCES
ADD ONE DISTANCE
CORRECT ACREAGE

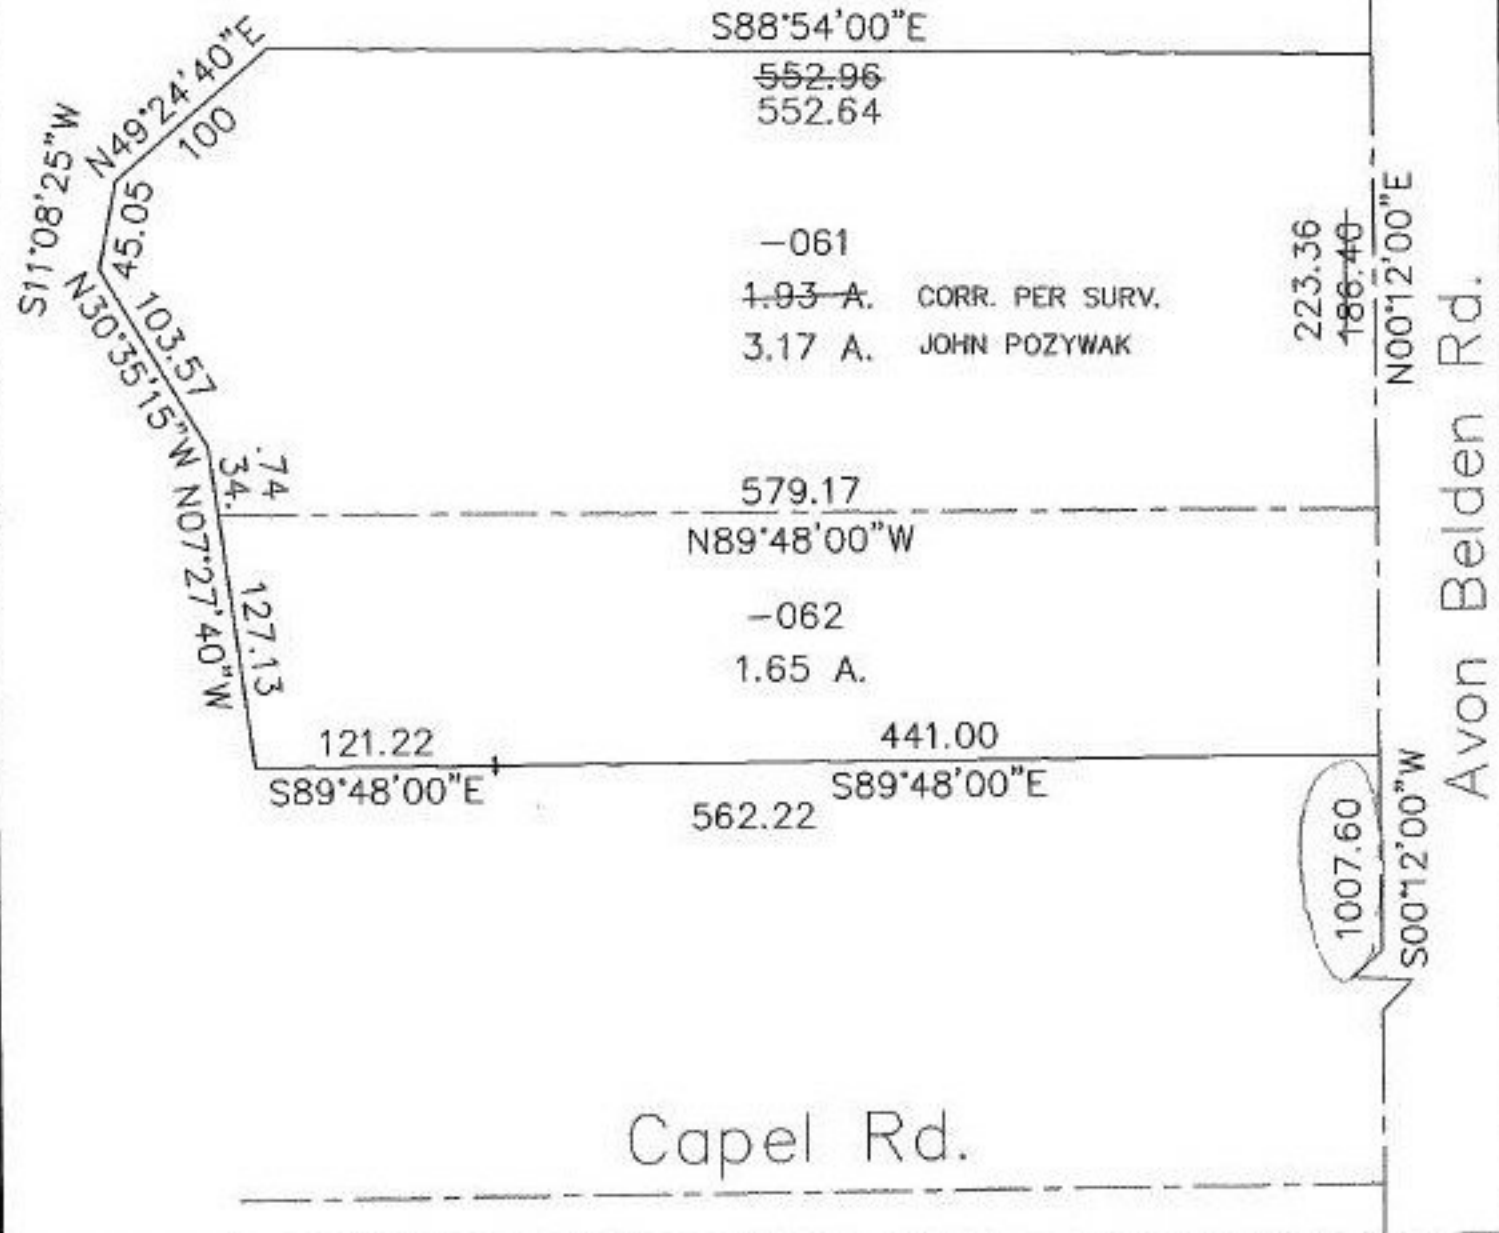

-061
1.93 A. CORR. PER SURV.
3.17 A. JOHN POZYWAK

-062
1.65 A.

Capel Rd.

Avon Belden Rd.

SURVEYED BY: John Poznyak
 CLOSURE: 6.63:10.000
 MAP PAGE(S): 11-00-057-B
 APPROVED BY: kac DATE: 5/7/98
 SCALE: 1" = 100 PRIOR INSTRUMENT: OR 1390/759

1-28-99

SPLITS/DEEDS PROCESSED

LORAIN COUNTY TAX MAP DEPARTMENT
226 MIDDLE AVE. ELYRIA, OHIO