

PARENT PARCEL: 03-00-030-102-006


CHILD PARCEL: 03-00-030-102-009 thru -013

STARTING POINT: cl. of Lake Breeze Rd. & cl. of South Ave.

NO. 22519




N89°58'00"W South Ave. N89°58'00"W 30'

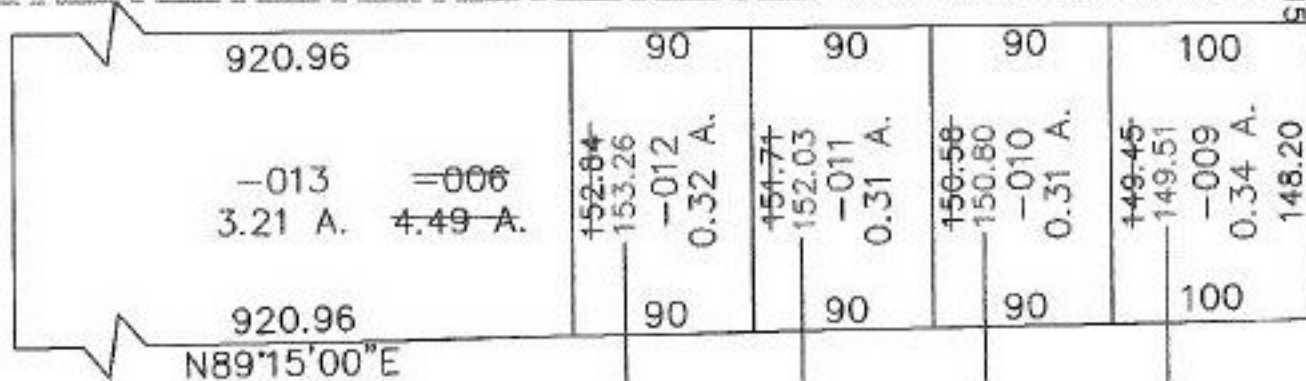

Lake Breeze Rd.

REVISED
10/20/98
REVISED J. POZYWAK SURVEY
APRIL 98

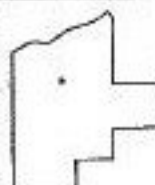

SPLITS/DEEDS PROCESSED
LORAIN COUNTY TAX MAP DEPARTMENT
226 MIDDLE AVE. ELYRIA, OHIO

SURVEYED BY: John Pozwyak
CLOSURE: XXXXXX
MAP PAGE(S): 03-00-030-X B
APPROVED BY: kac DATE: 5/12/98
SCALE: 1" = 100' PRIOR INSTRUMENT: