


PARENT PARCEL: 04-00-013-000-097

CHILD PARCEL: 04-00-013-000-207, 208

STARTING POINT: CL. OF WOOSTER - AVON LAKE RD. & CL. OF MILLS RD.

NO. 22522

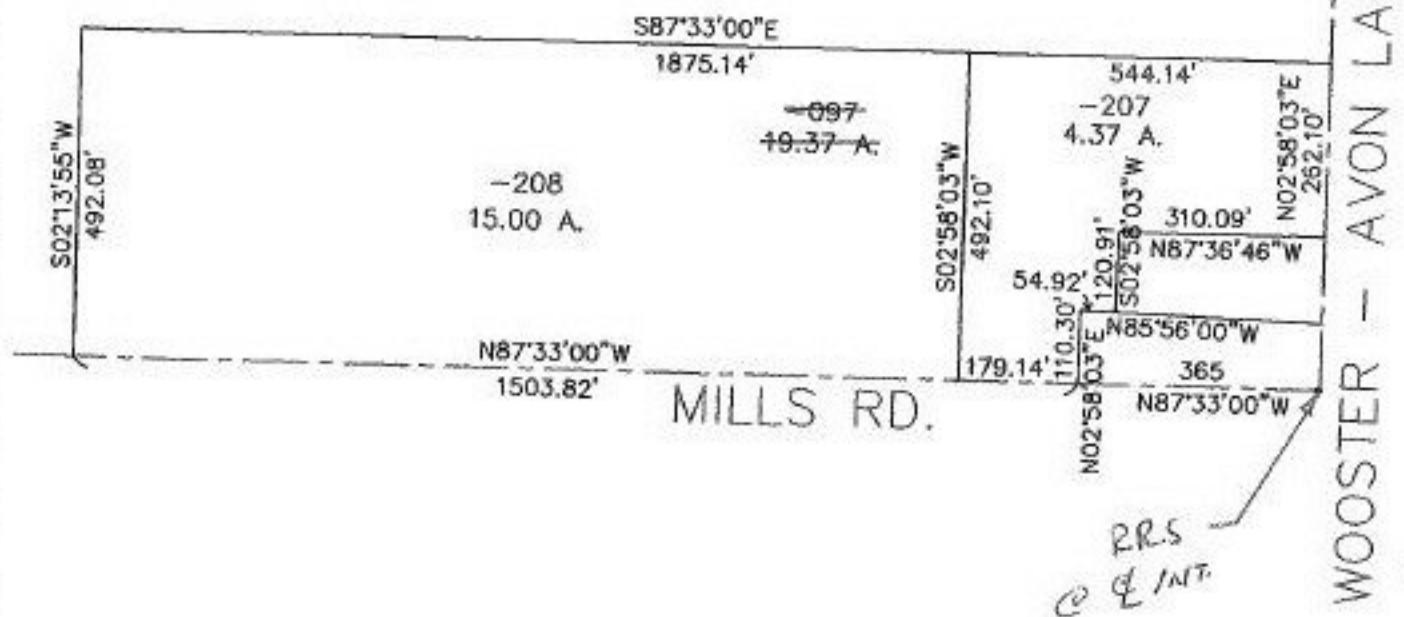

**SPLITS/DEEDS PROCESSED**  
 LORAIN COUNTY TAX MAP DEPARTMENT  
 226 MIDDLE AVE. ELYRIA, OHIO

SURVEYED BY: CHARLES A. KERG  
 CLOSURE: 0.01 : 10.000  
 MAP PAGE(S): 04-00-013 E & F  
 APPROVED BY: TJS DATE: 05/15/98  
 SCALE: 1" = 300' PRIOR INSTRUMENT: OR 0898/654