

PARENT PARCEL: 03-00-011-102-060


CHILD PARCEL: XX-XX-XXX-XXX-XXX

STARTING POINT: CL. OF ABBE RD. & S.E. CORNER OF O.L. 11

NO. 22523-D



*VOID
SEE
22699-A*

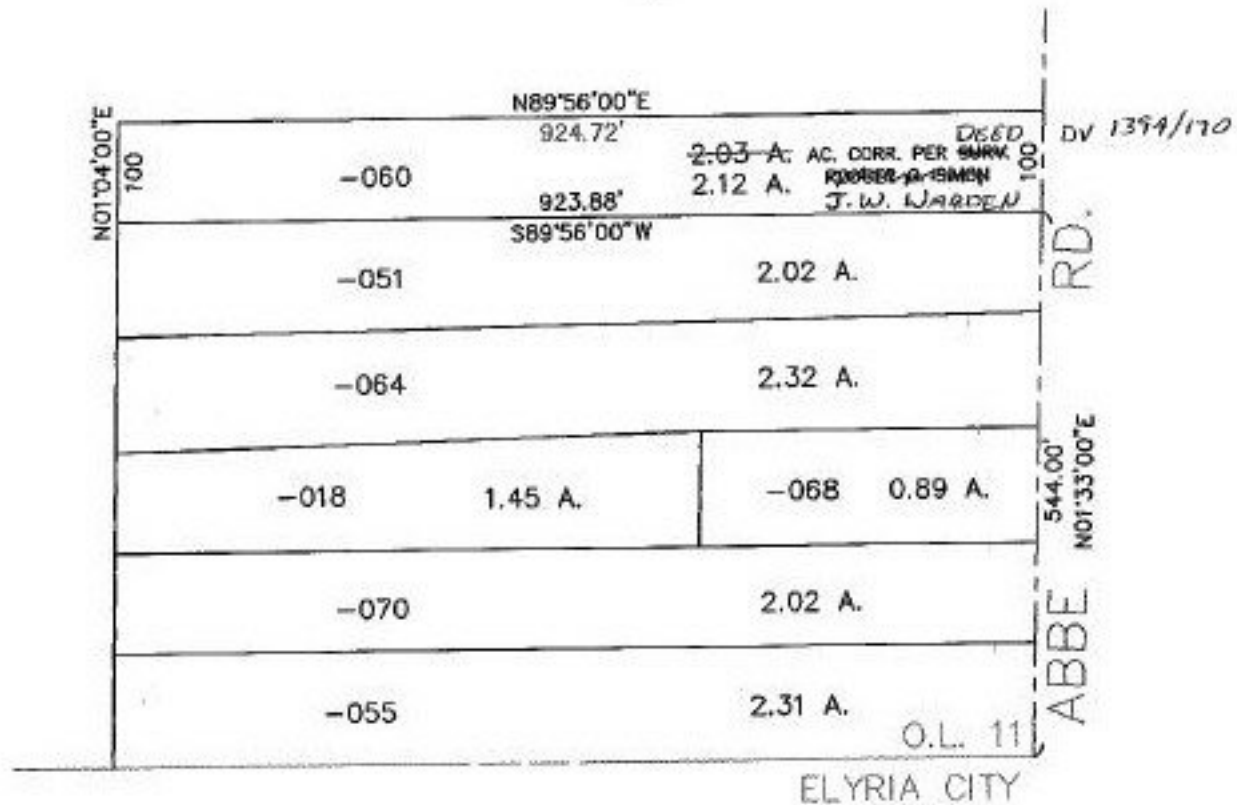

SPLITS/DEEDS PROCESSED

LORAIN COUNTY TAX MAP DEPARTMENT
226 MIDDLE AVE. ELYRIA, OHIO

SURVEYED BY: J.W. WARDEN & ASSOC.

CLOSURE: 0.10 : 10.000

MAP PAGE(S): 03-00-011-B

APPROVED BY: TJS DATE: 05/22/98

SCALE: 1" = 200' PRIOR INSTRUMENT: DV 1394/170