


PARENT PARCEL: 11-00-006-000-065

CHILD PARCEL: 11-00-006-000-066, 067

STARTING POINT: CL. OF ELYRIA - TWINSBURG RD. & HAWKE RD.

NO. 22528

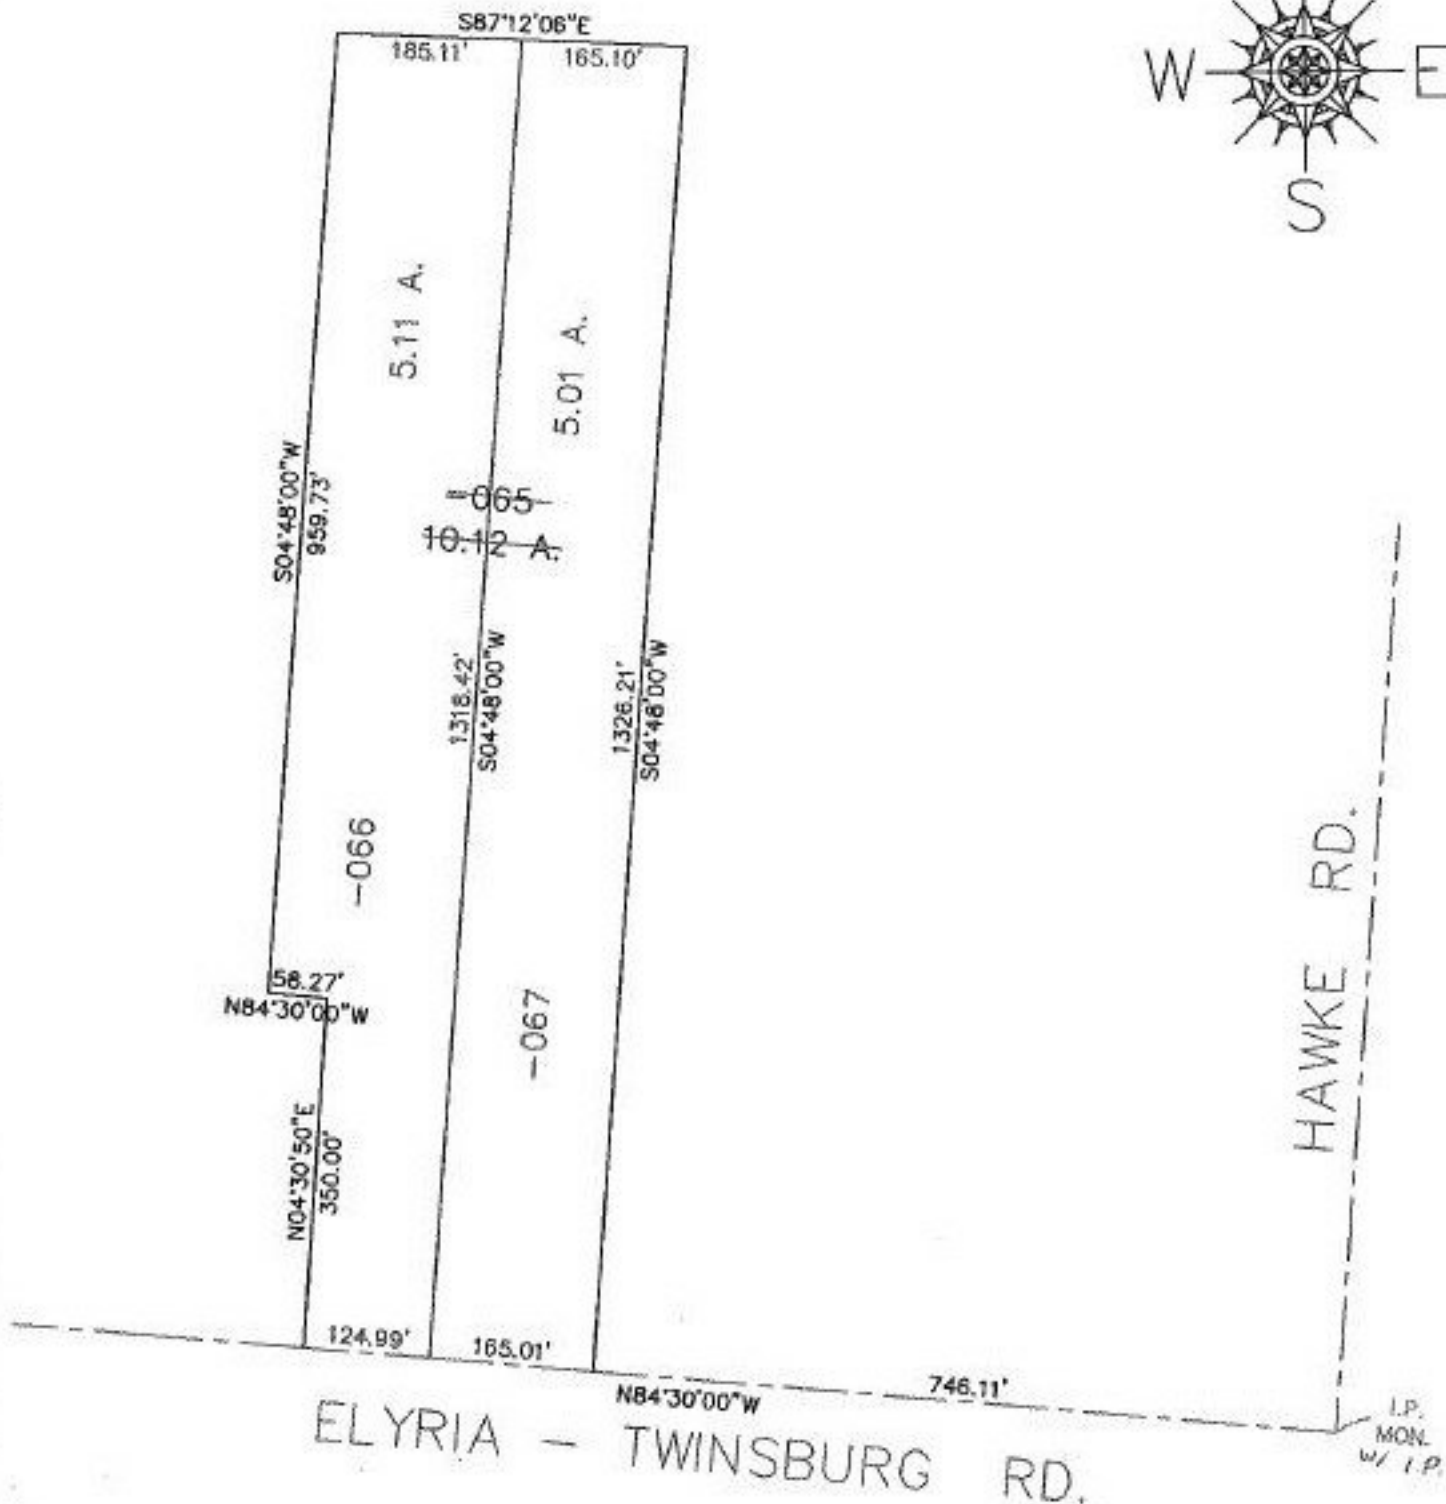

1-28-99

SPLITS/DEEDS PROCESSED
LORAIN COUNTY TAX MAP DEPARTMENT
226 MIDDLE AVE. ELYRIA, OHIO

SURVEYED BY: RODGER C. SIMON
 CLOSURE: 0.04 : 10,000
 MAP PAGE(S): 11-00-006-B
 APPROVED BY: TJS DATE: 05/22/98
 SCALE: 1" = 200' PRIOR INSTRUMENT: 970475194