

PARENT PARCEL: 11-00-047-000-013

CHILD PARCEL: XX-XX-XXX-XXX-XXX


STARTING POINT: CL OF AVON - BELDEN RD. & CL OF COOLEY RD.

NO. 22539-A



COOLEY RD.

AVON - BELDEN RD.

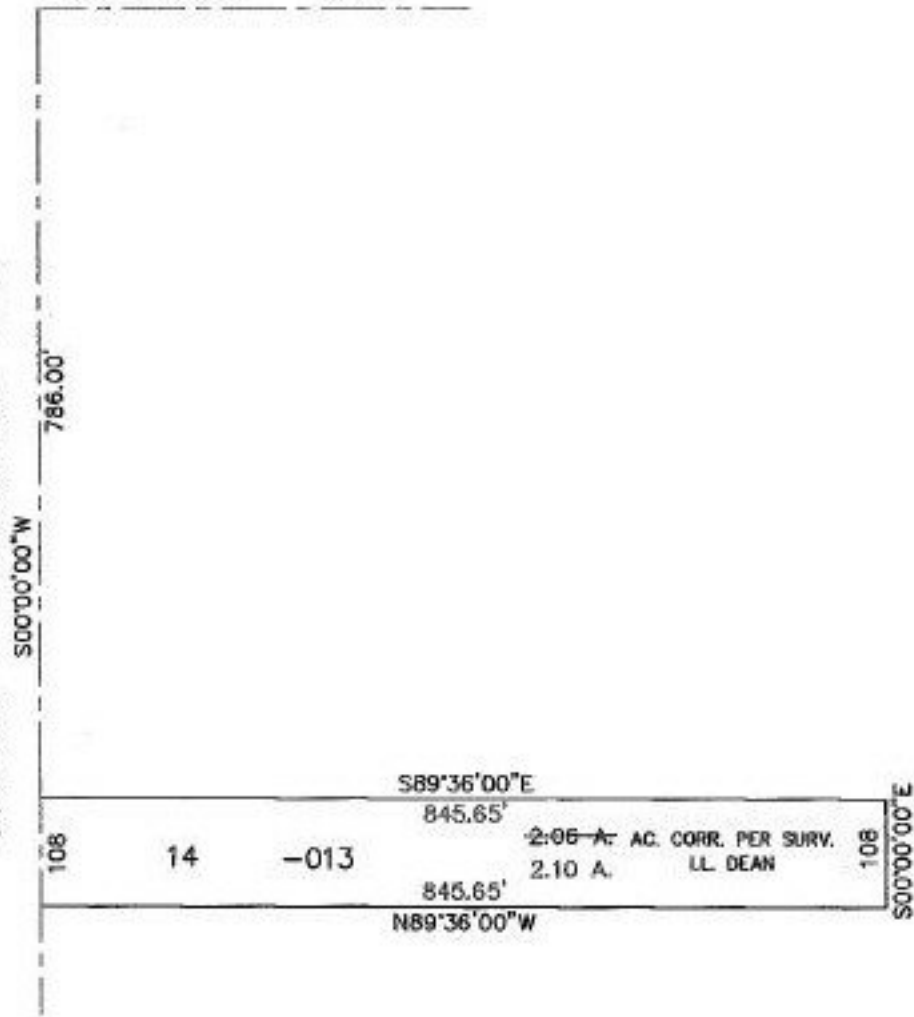

786.00'

S00°00'00\"W

S89°36'00\"E

845.65'

2-06-A AC. CORR. PER SURV.

2.10 A. LL. DEAN

845.65'

N89°36'00\"W

108

14

-013

108

S00°00'00\"E

1-28-99

SPLITS/DEEDS PROCESSED

LORAIN COUNTY TAX MAP DEPARTMENT
226 MIDDLE AVE. ELYRIA, OHIO

SURVEYED BY: J. L. DEAN

CLOSURE: 0.00 : 10.000

MAP PAGE(S): 11-00-047-A

APPROVED BY: TJS DATE: 06/16/98

SCALE: 1" = 200' PRIOR INSTRUMENT: DV 504/77