


PARENT PARCEL: 01-00-039-000-037


CHILD PARCEL: 01-00-039-000-047, & 048

STARTING POINT: MON. BOX SITUATED AT THE N.W. CORNER OF O.L. 39 & CL. OF BAUMHART RD.

NO. 22539

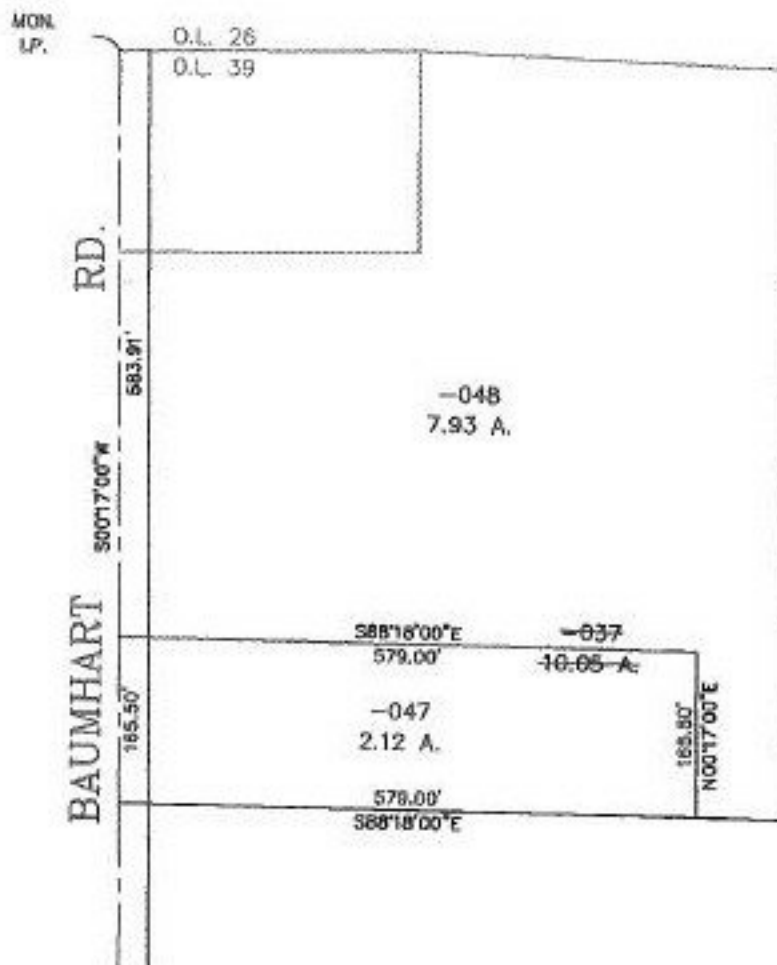

TS
2-19-99

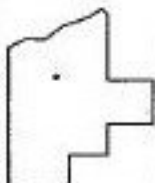

SPLITS/DEEDS PROCESSED
LORAIN COUNTY TAX MAP DEPARTMENT
 226 MIDDLE AVE. ELYRIA, OHIO

SURVEYED BY: CHARLES E HAMANN
 CLOSURE: 0.00 : 10.000
 MAP PAGE(S): 1-H
 APPROVED BY: JS DATE: 06/15/98
 SCALE: 1" = 200' PRIOR INSTRUMENT: OR 160/236