


#22525A1

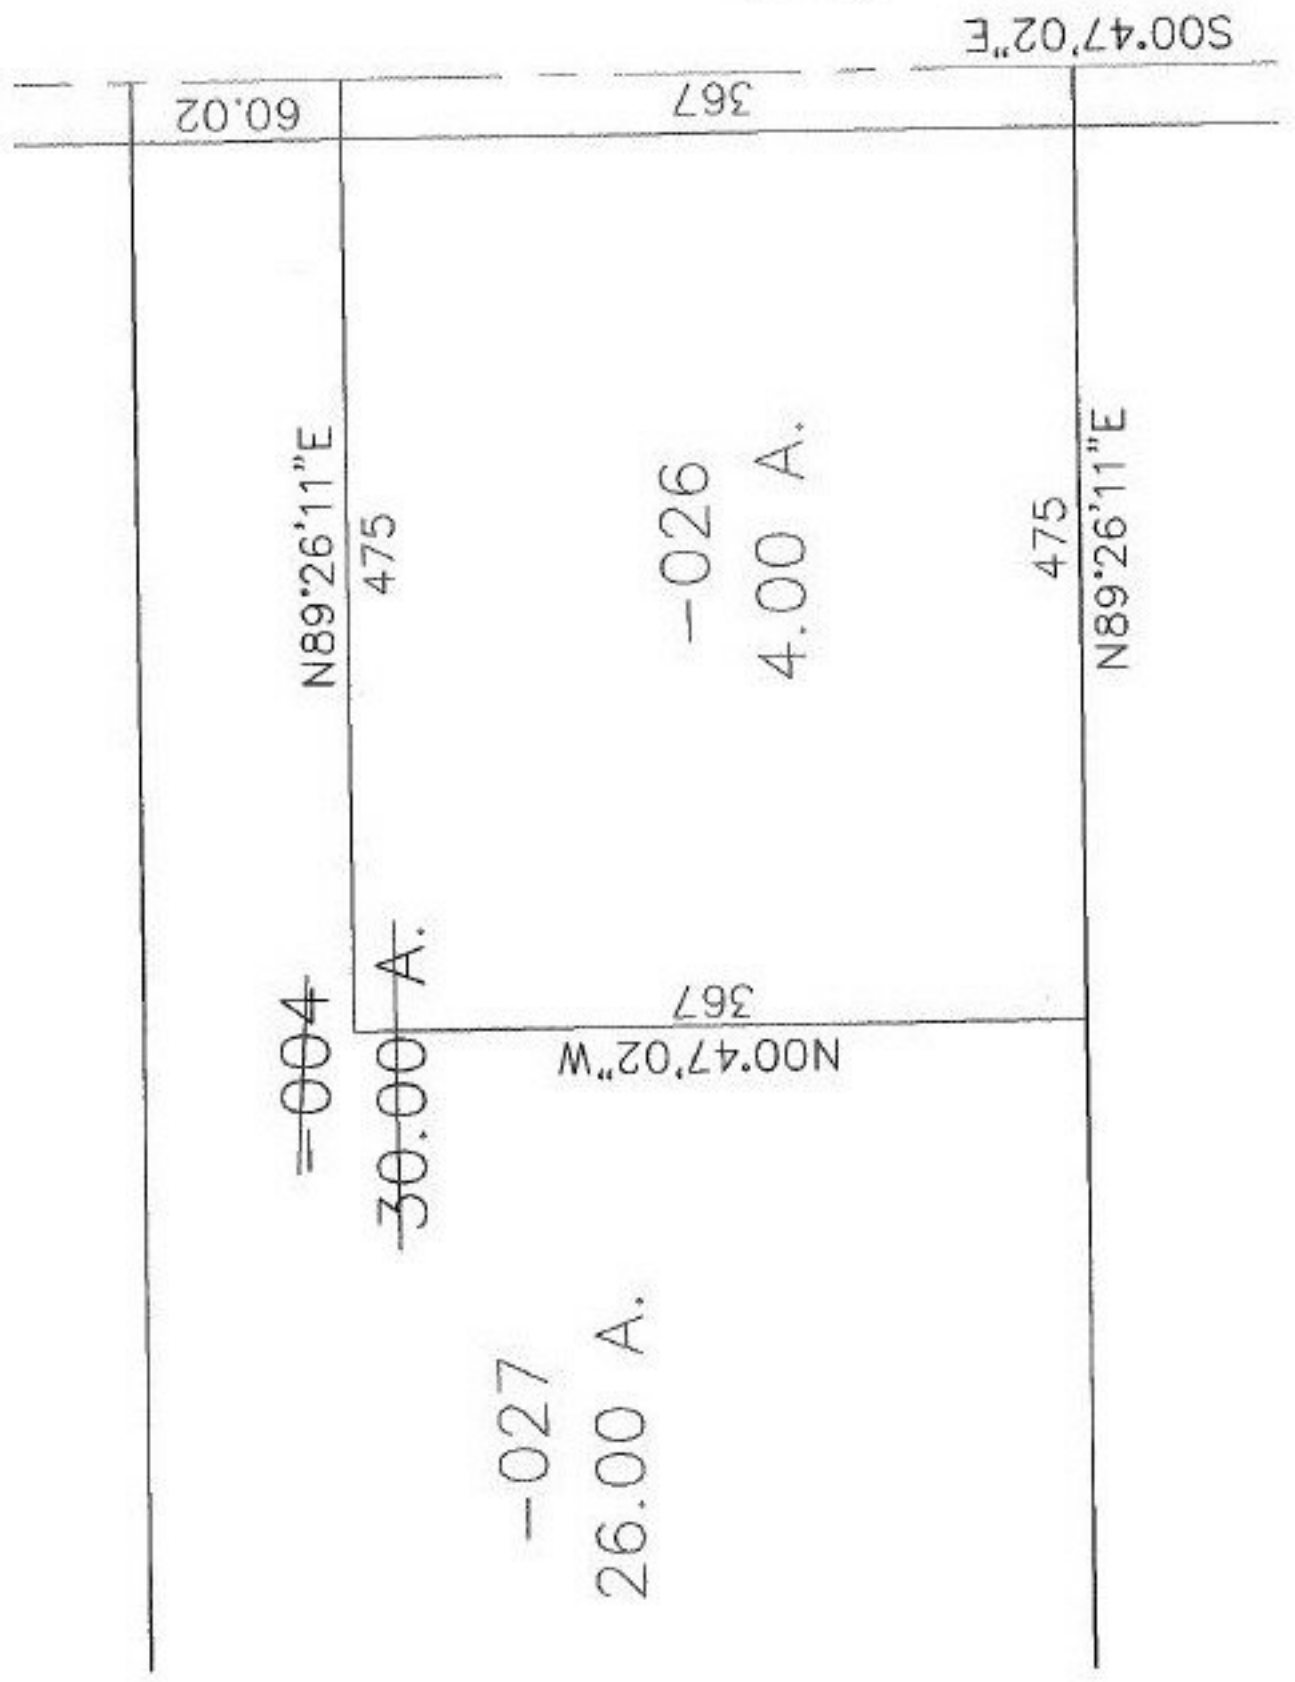

~~=004~~

~~30.00 A.~~

-027  
26.00 A.

-026  
4.00 A.

367  
N00°47'02"W

475  
N89°26'11"E

RD.

S00°47'02"E

60.02

367