



-17
6.58

9.

ACREAGE CORRECTION
 PER 970 476 736
 & MAP DEPT. CRC FROM
 J. POZYWAK SURVEY






DOC. NO. 970 476 736

04-00-013-000-206 1.14 A 7/13/97
 CALC ACRES = 1.22 A.



#22303-X

WOOSTER AVON LAKE

0.07 A.

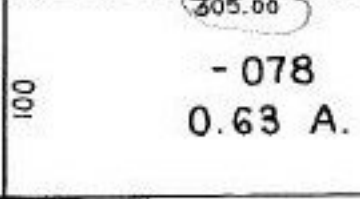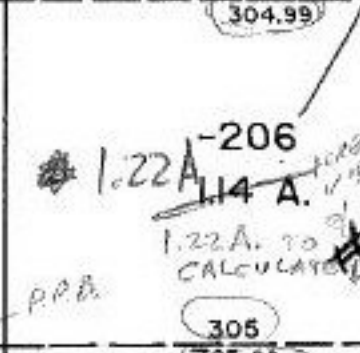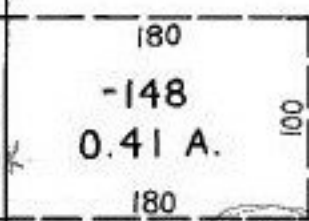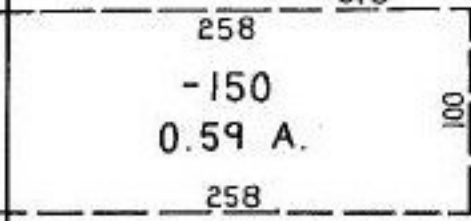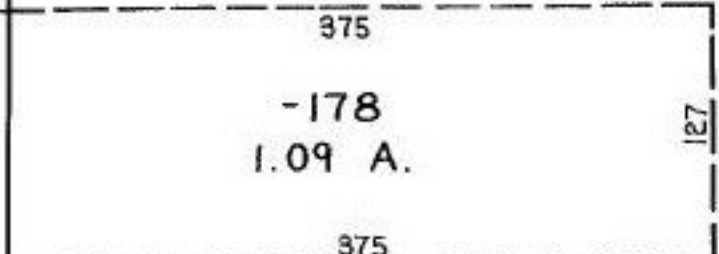

#22541-A

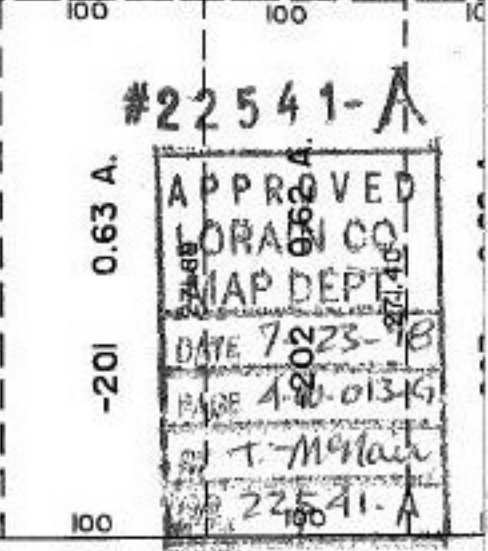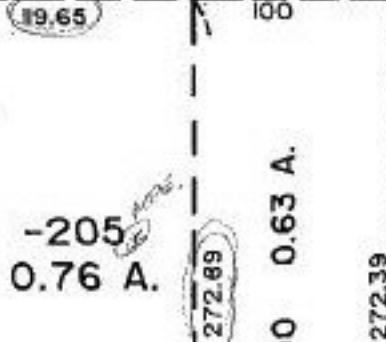

#22541-A
 APPROVED
 LORAIN CO
 MAP DEPT.
 DATE 7-23-98
 PAGE 4-0-01346
 T. McHair
 22541-A


MILLS

427.46

827.46

1027.46

305

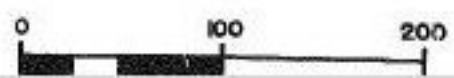

SEE