

PARENT PARCEL: 04-00-013-000-204


CHILD PARCEL: XX-XX-XXX-XXX-XXX

STARTING POINT: CL. OF WOOSTER - AVON LAKE RD. & CL. OF MILLS RD.

NO. 22541-A



WOOSTER - AVON LAKE RD.

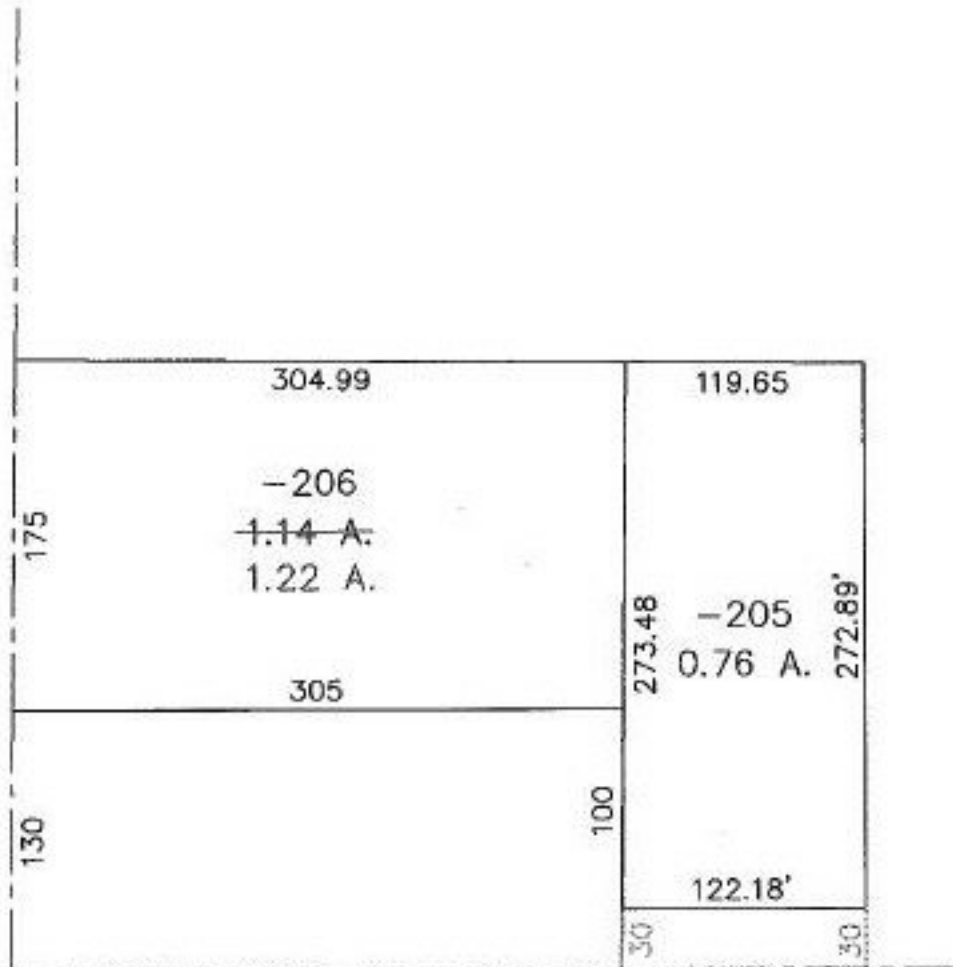

MILLS RD.



SPLITS/DEEDS PROCESSED
LORAIN COUNTY TAX MAP DEPARTMENT
226 MIDDLE AVE. ELYRIA, OHIO

SURVEYED BY: JOHN POZYWAK
CLOSURE: 0.14 : 10,000
MAP PAGE(S): 4-00-013-G
APPROVED BY: TJS DATE: 06/03/98
SCALE: 1" = 100' PRIOR INSTRUMENT: OR 1201/443

2-24-98 AND 7-23-98