


#22546-SEE 6-82

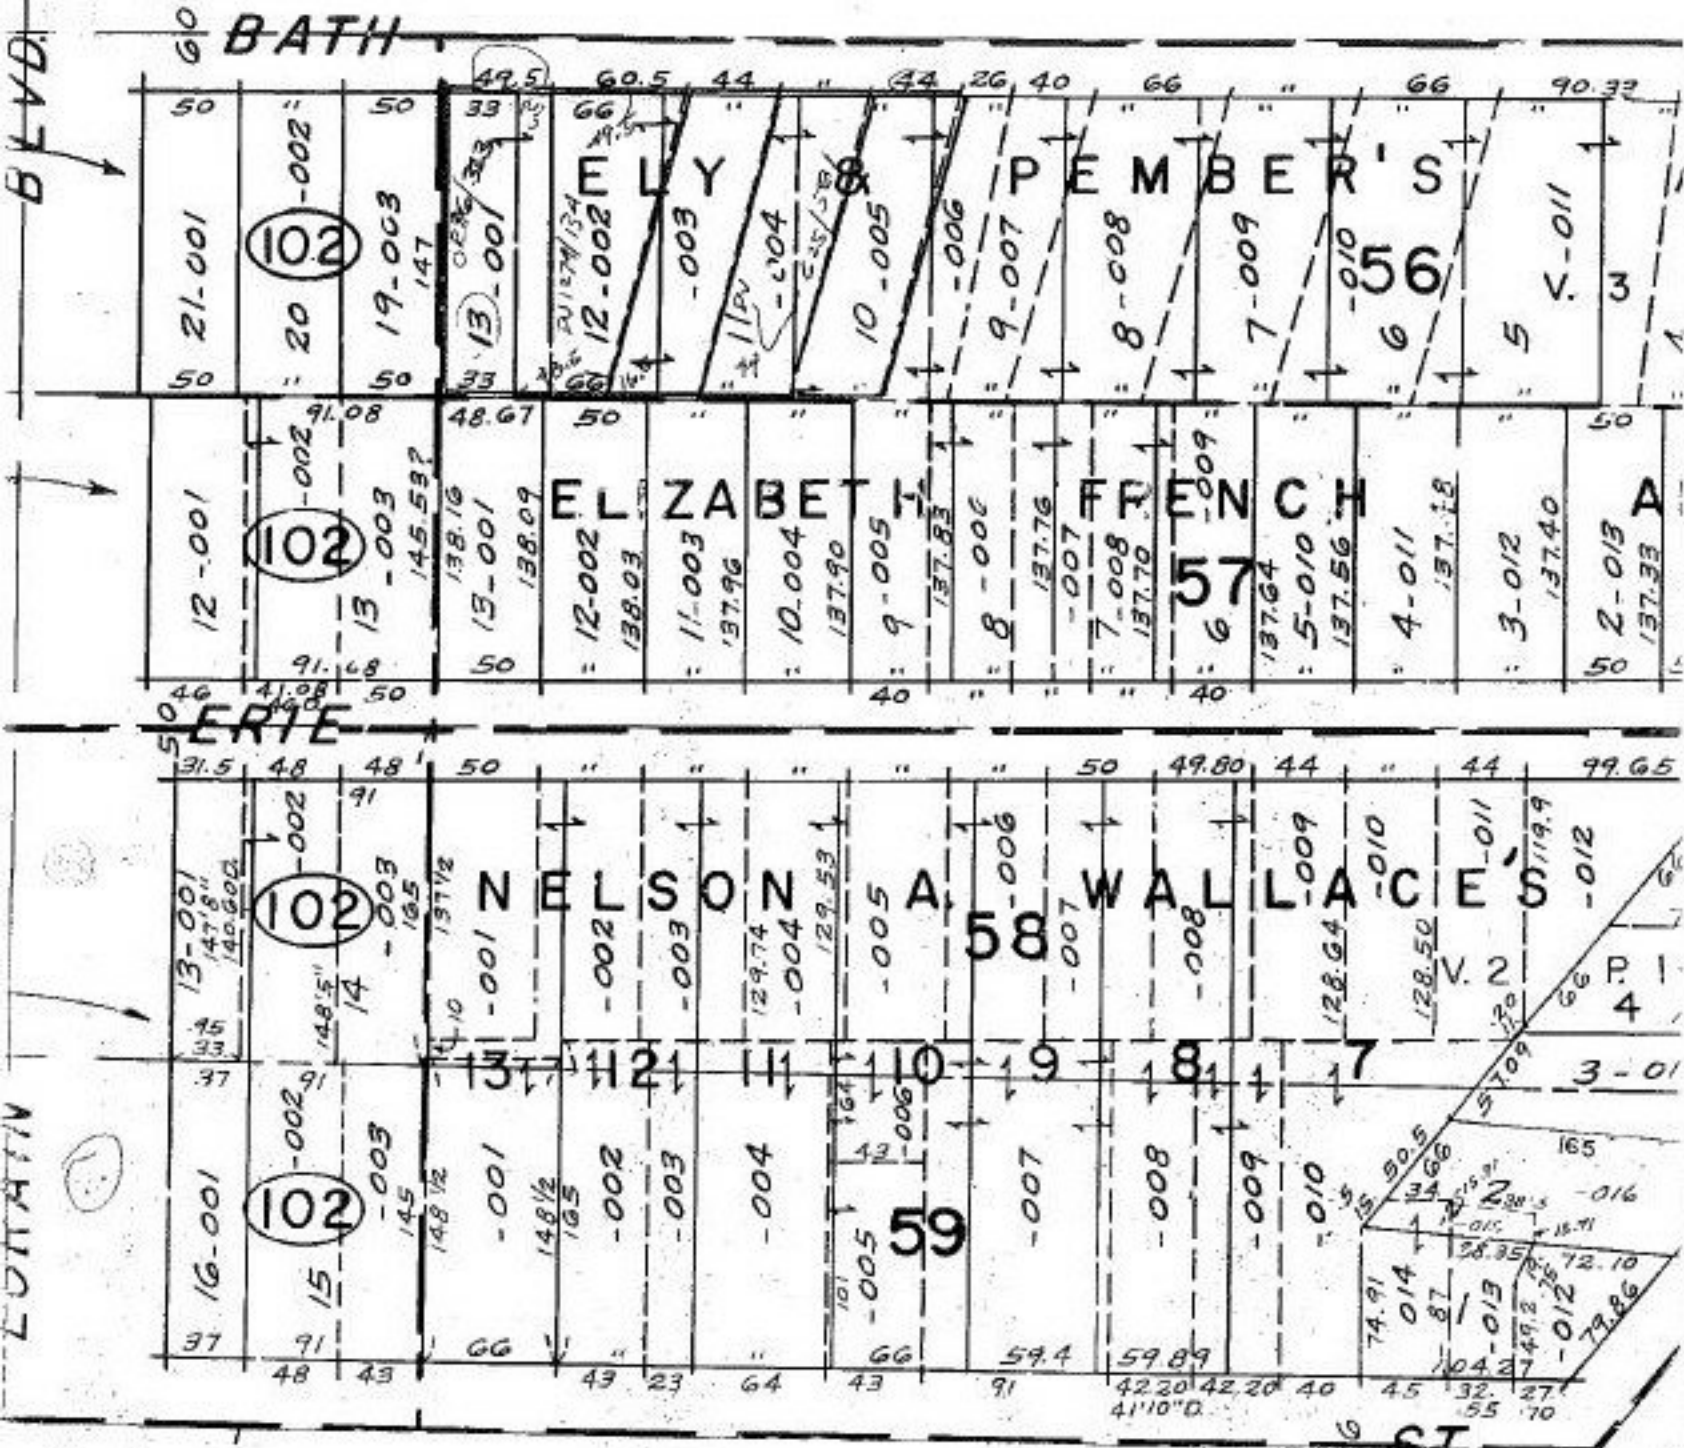

#22546-D

### DEED CHECK

THIS WAS REDO OF #19190-A 10.24.90

REFERENCE -

- SL -003 OR 294/33
- 13-001 OR 96/323
- 12-002 DV 1274/134
- 11-004 DV 625/581
- 11-005 DV 436/229

APPROVED
LORAIN CO.
MAP DEPT.
DATE 10.1.98
PAGE 6-100
BY T-M Main
22546-D