


PARENT PARCEL: 12-00-040-101-054

CHILD PARCEL: 12-00-040-101-059, -060

STARTING POINT: CL OF SPRAGUE RD. & CL OF COLUMBIA RD.

NO. 22548

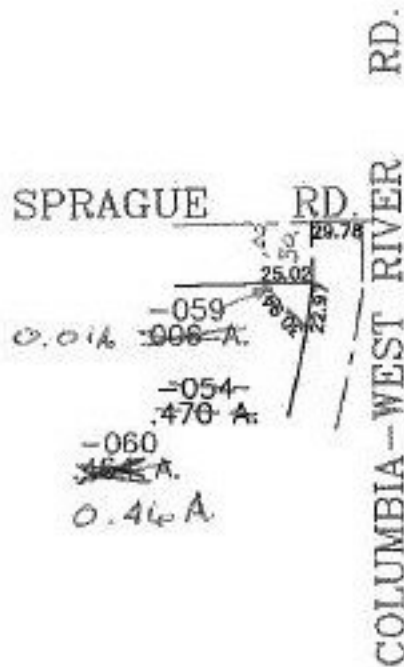

SPLITS/DEEDS PROCESSED

LORAIN COUNTY TAX MAP DEPARTMENT
226 MIDDLE AVE. ELYRIA, OHIO

SURVEYED BY: ROBERT S. WYND, ODOT

CLOSURE: 0.75 : 10,000

MAP PAGE(S): 12-00-040-B

APPROVED BY: JAH DATE: 06-15-98

SCALE: 1" = 100' PRIOR INSTRUMENT: