


PARENT PARCEL: 12-00-021-101-001

CHILD PARCEL: 12-00-021-101-020, -021

STARTING POINT: CL OF COLUMBIA RD. & SPRAGUE RD.

NO. 22549

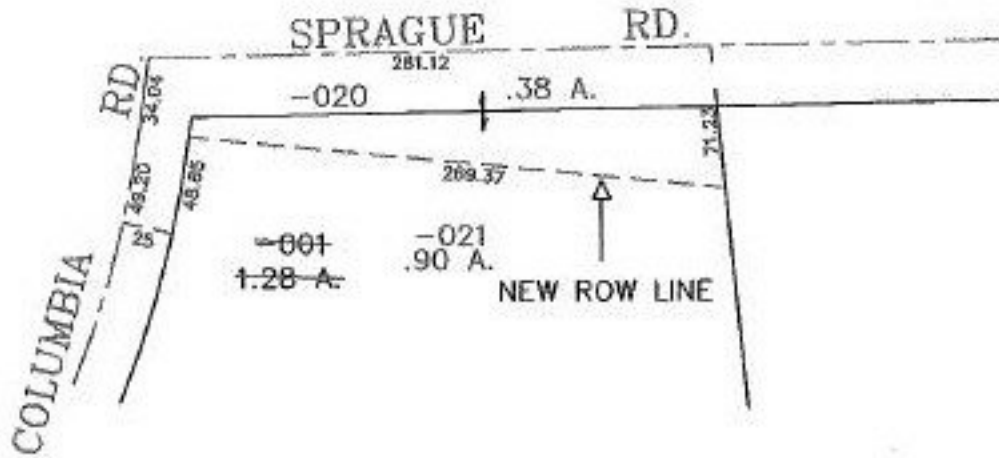

SPLITS/DEEDS PROCESSED

LORAIN COUNTY TAX MAP DEPARTMENT
226 MIDDLE AVE. ELYRIA, OHIO

SURVEYED BY: ROBERT S. WYND

CLOSURE: 0.12 : 10,000

MAP PAGE(S): 12-00-021-A

APPROVED BY: JAH DATE: 6-16-98

SCALE: 1" = 100' PRIOR INSTRUMENT: DV 1194/414