


PARENT PARCEL: 04-00-024-114-017

CHILD PARCEL: 04-00-024-114-049, 050

STARTING POINT: CL OF ST. FRANCIS DRIVE & CL OF SPRINGBROOK DR.

NO. 22550

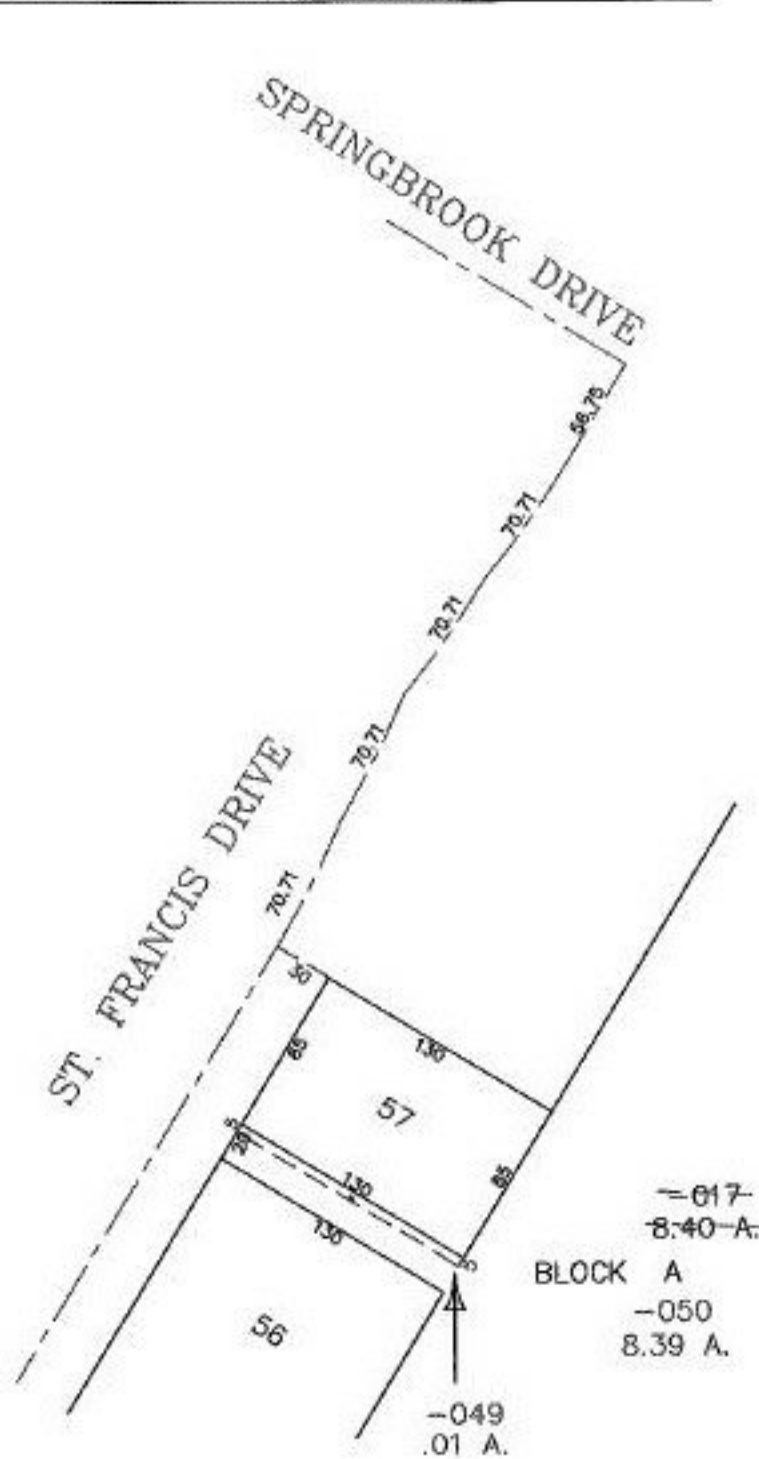

-017-
-8.40-A-
BLOCK A
-050
8.39 A.

-049
.01 A.



SPLITS/DEEDS PROCESSED

LORAIN COUNTY TAX MAP DEPARTMENT
226 MIDDLE AVE. ELYRIA, OHIO

SURVEYED BY: DAVID L. ELWELL

CLOSURE: 0.00 : 10.000

MAP PAGE(S): 04-00-024-H

APPROVED BY: FC. JAH DATE: 6-17-98

SCALE: 1" = 100' PRIOR INSTRUMENT: FILM 57144