


PARENT PARCEL: 21-15-000-000-051

CHILD PARCEL: 21-15-000-000-063, 064

STARTING POINT: CL OF HAWLEY RD. & CL OF NEW LONDON EASTERN RD.

NO. 22552

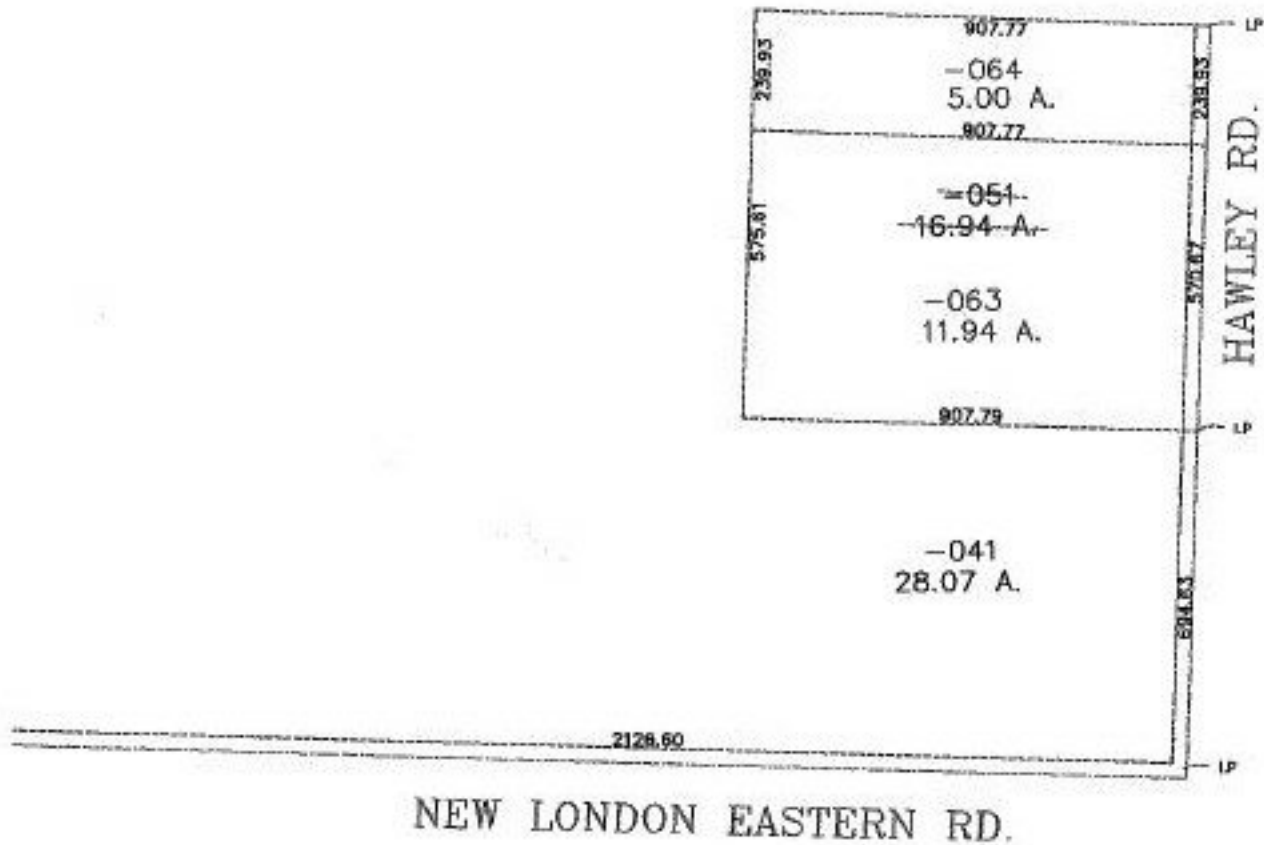

CORRECTED MAP 2-1-2000

P.P. No. SWITCH


SURVEYED BY: RONALD L. LAUGHERY

CLOSURE: 0.03 : 10,000

MAP PAGE(S): 21-G

APPROVED BY: JAH DATE: 6-16-98

SCALE: 1" = 400' PRIOR INSTRUMENT: DY 746/524

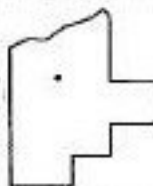

**SPLITS/DEEDS PROCESSED**  
LORAIN COUNTY TAX MAP DEPARTMENT  
226 MIDDLE AVE. ELYRIA, OHIO