


SEE

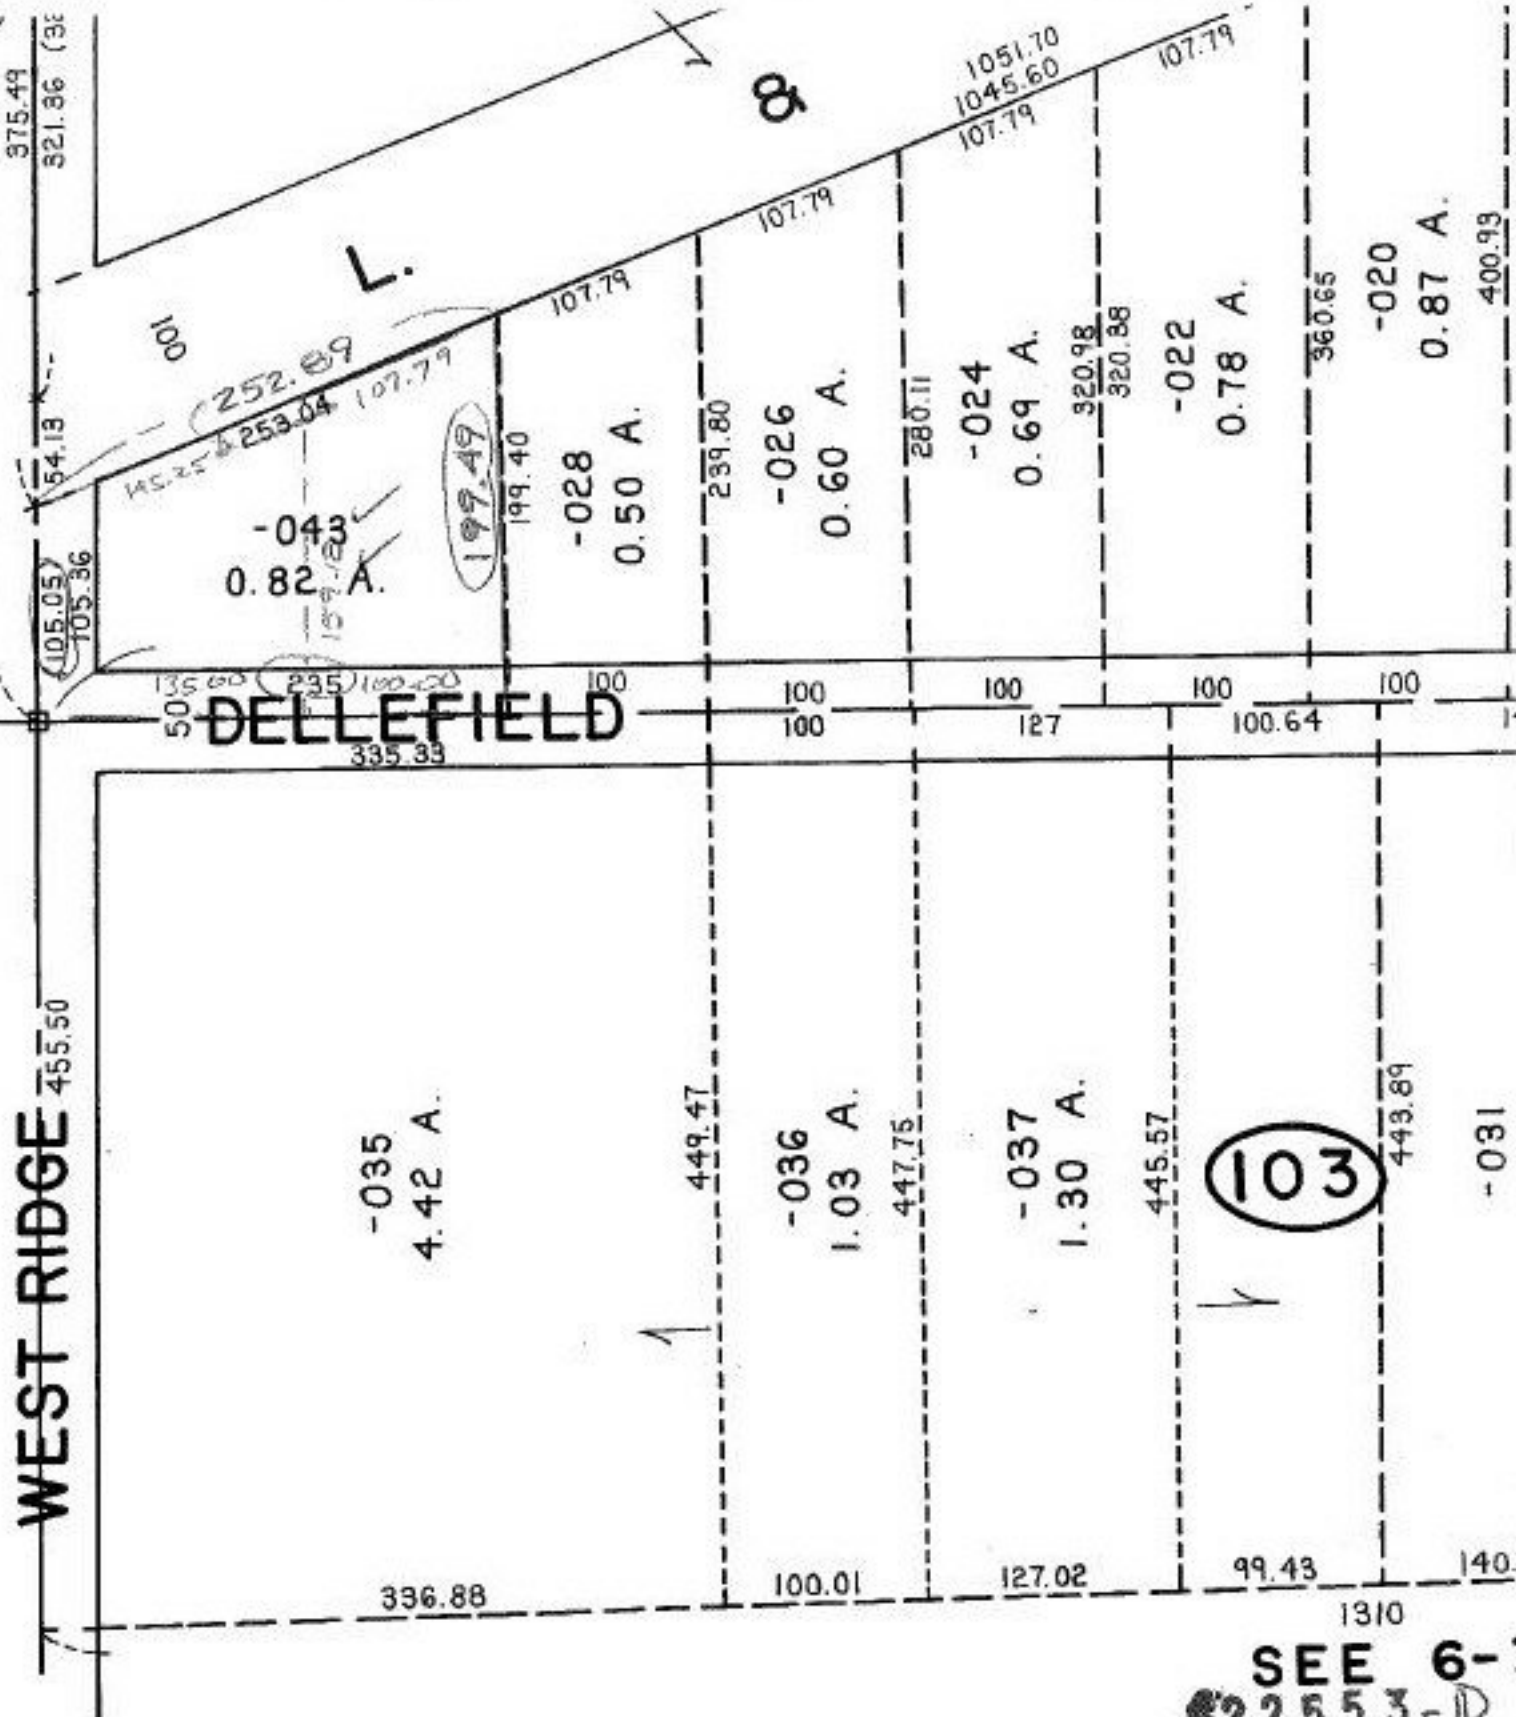

* DEED CHECK ON A PRIOR COMB. NEEDS TO BE RESULT OF SURVEY

SEE DV 1420/477 DV 1422/506

SEE 6-3
#22553-D

APPROVED LORAIN CO. MAP DEPT.	
DATE 5-27-98	
PAGE 6-19	
BY T.M. New	
MAP NO.	22553-D