

PARENT PARCEL: 03-00-014-000-023

CHILD PARCEL: 03-00-014-000-050, -051

STARTING POINT: NE CORNER OF O.L. 14


NO. 22558



NE CORNER OF O.L. 14

ROAD

684.32

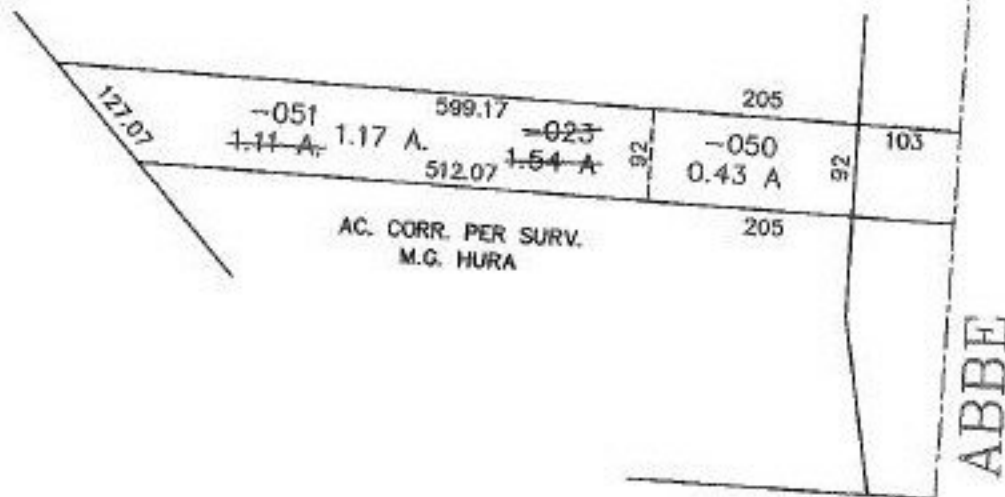

SPLITS/DEEDS PROCESSED

LORAIN COUNTY TAX MAP DEPARTMENT
226 MIDDLE AVE. ELYRIA, OHIO

SURVEYED BY: M. G. HURA

CLOSURE: 0.00 PER 10,000

MAP PAGE(S): 3-00-014-B

APPROVED BY: F. COLBERT DATE: 6/24/98

SCALE: 1" = 200' PRIOR INSTRUMENT: DV 1024/142