

PARENT PARCEL: 03-00-014-000-003 & -025

CHILD PARCEL: 03-00-014-000-052 & -053

STARTING POINT: NE CORNER OF O.L. 14

NO. 22559




NE CORNER OF O.L. 14

ROAD

572.32

ABBE

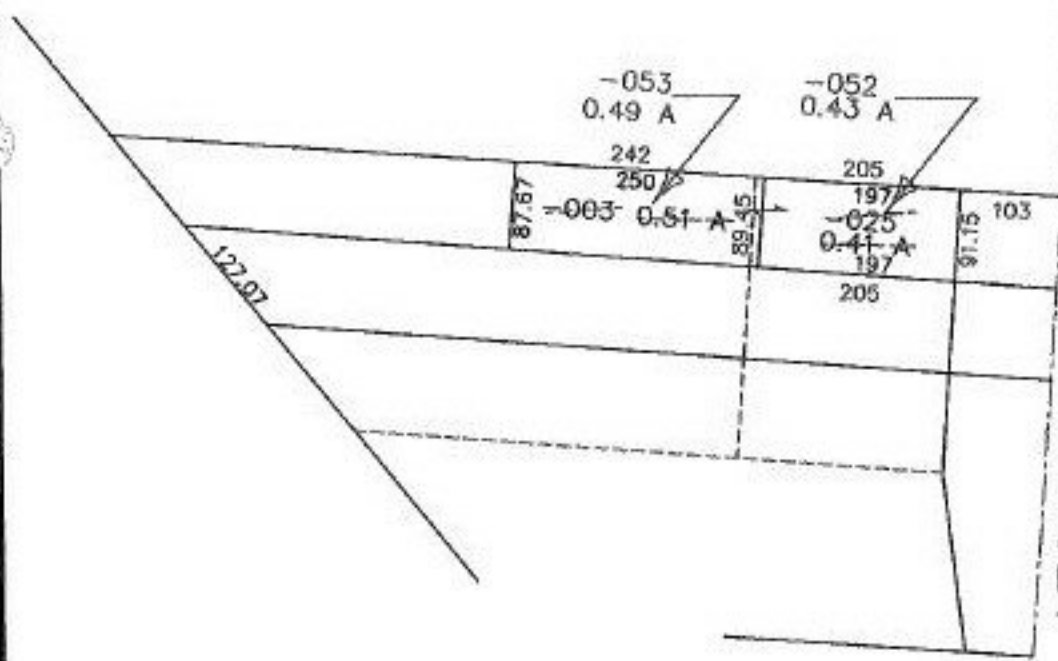

SPLITS/DEEDS PROCESSED

LORAIN COUNTY TAX MAP DEPARTMENT
226 MIDDLE AVE. ELYRIA, OHIO

SURVEYED BY: M. G. HURA

CLOSURE: 0.05 PER 10,000

MAP PAGE(S): 3-00-014-B

APPROVED BY: F. COLBERT DATE: 6/24/98

SCALE: 1" = 200' PRIOR INSTRUMENT: 98053303B