


#22560

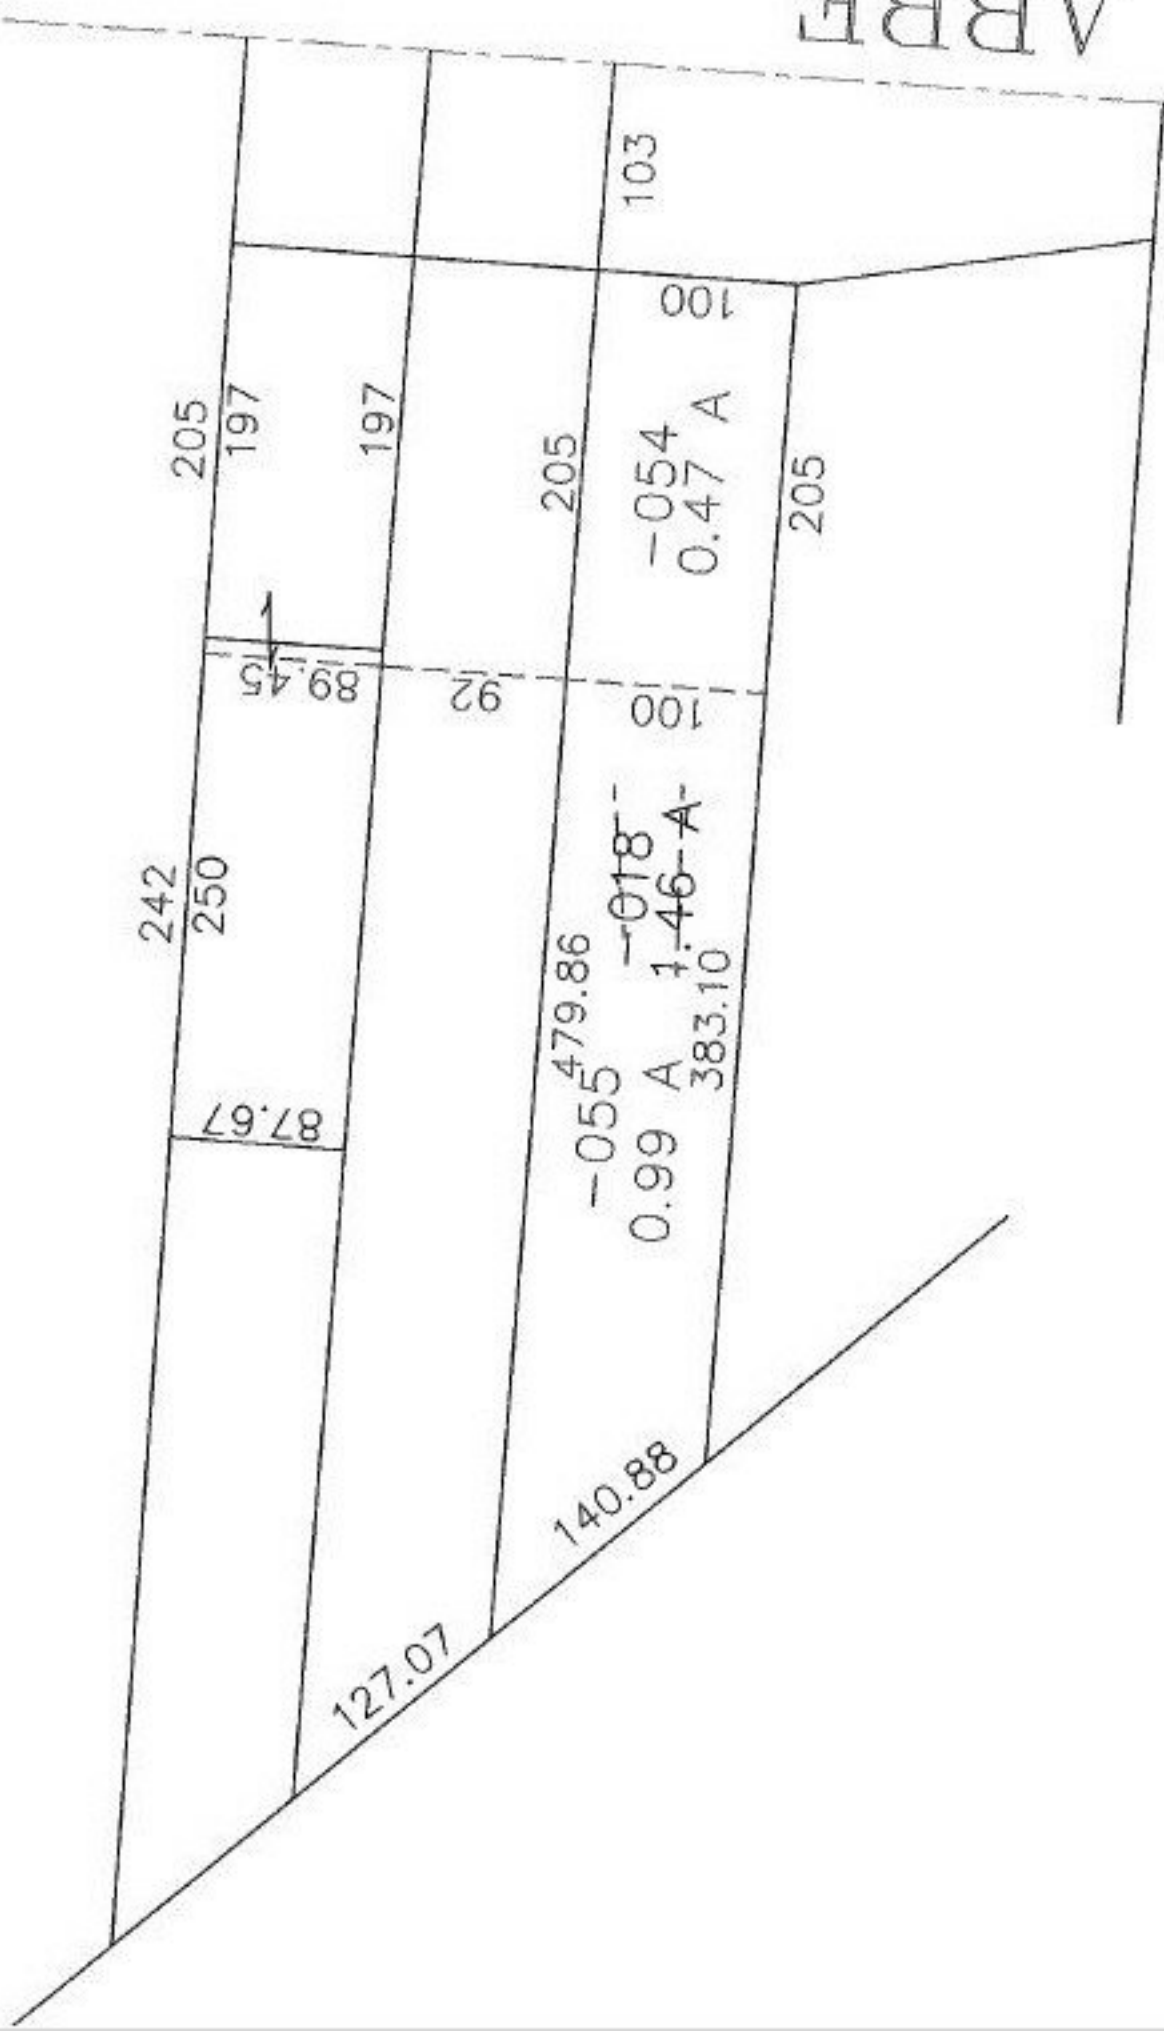

ABBE