


PARENT PARCEL: 13-11-015-500-004

CHILD PARCEL: XX-XX-XXX-XXX-XXX

STARTING POINT: BEGINNING AT THE S.E. CORNER OF S/L 56 IN VILAGE OF KIPTON, PLAT VI P.10

NO. 22564-D

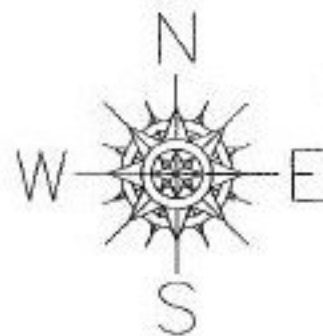

DEED CHECK

22564-D-1 OK

22564-D-2 OK

22564-D-3 OK

22564-D-4 OK 13-11-015-500-004 ~~1.52 A.~~ 1.41 A. AC. CORR. PER DEED

22564-D-5 OK

COPY

ORIG

6/21/99

1 OF 2



SPLITS/DEEDS PROCESSED
LORAIN COUNTY TAX MAP DEPARTMENT
226 MIDDLE AVE. ELYRIA, OHIO

SURVEYED BY: XXXXXXXXXXXX
CLOSURE: 0.18 : 10.000
MAP PAGE(S): 10-A&B, 9-D&H, 13-11-015
APPROVED BY: TJS DATE: 06/24/98
SCALE: 1" = 100' PRIOR INSTRUMENT: OR 672/879

6/21/99