


PARENT PARCEL: 03-00-108-104-034

CHILD PARCEL: 03-00-108-104-043 THRU 045

STARTING POINT:

NO. 22565-U

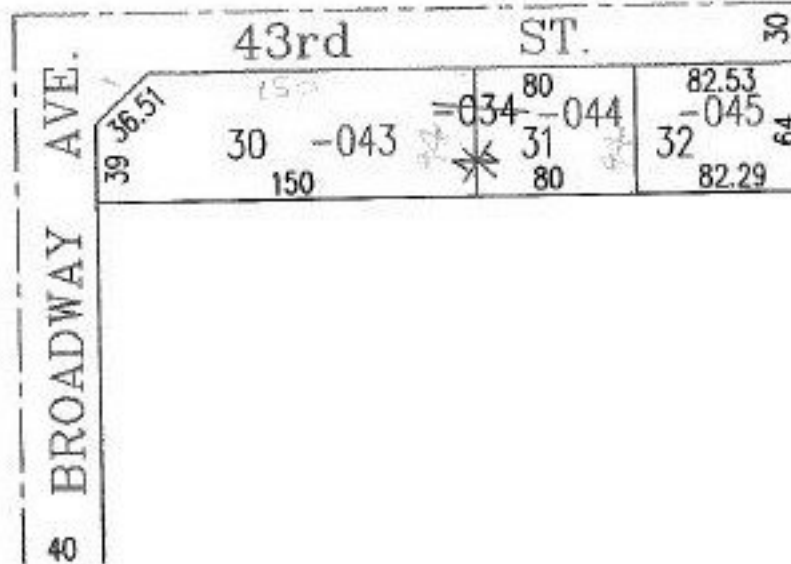

*TS*  
4-30-99



**SPLITS/DEEDS PROCESSED**  
LORAIN COUNTY TAX MAP DEPARTMENT  
226 MIDDLE AVE. ELYRIA, OHIO

SURVEYED BY: DEED  
CLOSURE:  
MAP PAGE(S): 03-00-108-A  
APPROVED BY: IJS DATE: 06/25/98  
SCALE: 1" = 100' PRIOR INSTRUMENT: DV 1295/321