


PARENT PARCEL: 14-00-009-000-013, 14-00-012-000-025, 14-00-013-000-009
CHILD PARCEL: XX-XX-XXX-XXX-XXX
STARTING POINT: SOUTH LINE OF O.L. 12 & ITS INT. WITH CL OF WHEELING & LAKE ERIE RR.

NO. 22566-D

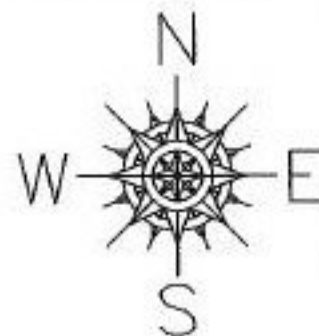

DEED CHECK

UPDATE LEGAL:	14-00-009-000-013	OK
UPDATE LEGAL:	14-00-012-000-025	OK
UPDATE LEGAL:	14-00-013-000-009	OK

*ADD AN UPDATED "INTEND TO CONVEY"
TO REFLECT 3 PARCELS LISTED*

*6-21-99
m.i.B.*



SPLITS/DEEDS PROCESSED
LORAIN COUNTY TAX MAP DEPARTMENT
226 MIDDLE AVE. ELYRIA, OHIO

SURVEYED BY: GARY E. PENEQUOND
CLOSURE: CAN'T RUN
MAP PAGE(S): 14-A & B
APPROVED BY: IJS DATE: 06/26/98
SCALE: 1" = 100' PRIOR INSTRUMENT: DV XXXX/XXX