



PARENT PARCEL: 15-00-035-000-034

CHILD PARCEL: 15-00-035-000-105, & 106

STARTING POINT: CL OF BIGGS RD. & CL OF LAGRANGE RD., OR N.W. CORNER OF O.L. 35

NO. 22570-A

UNCOMBINATION

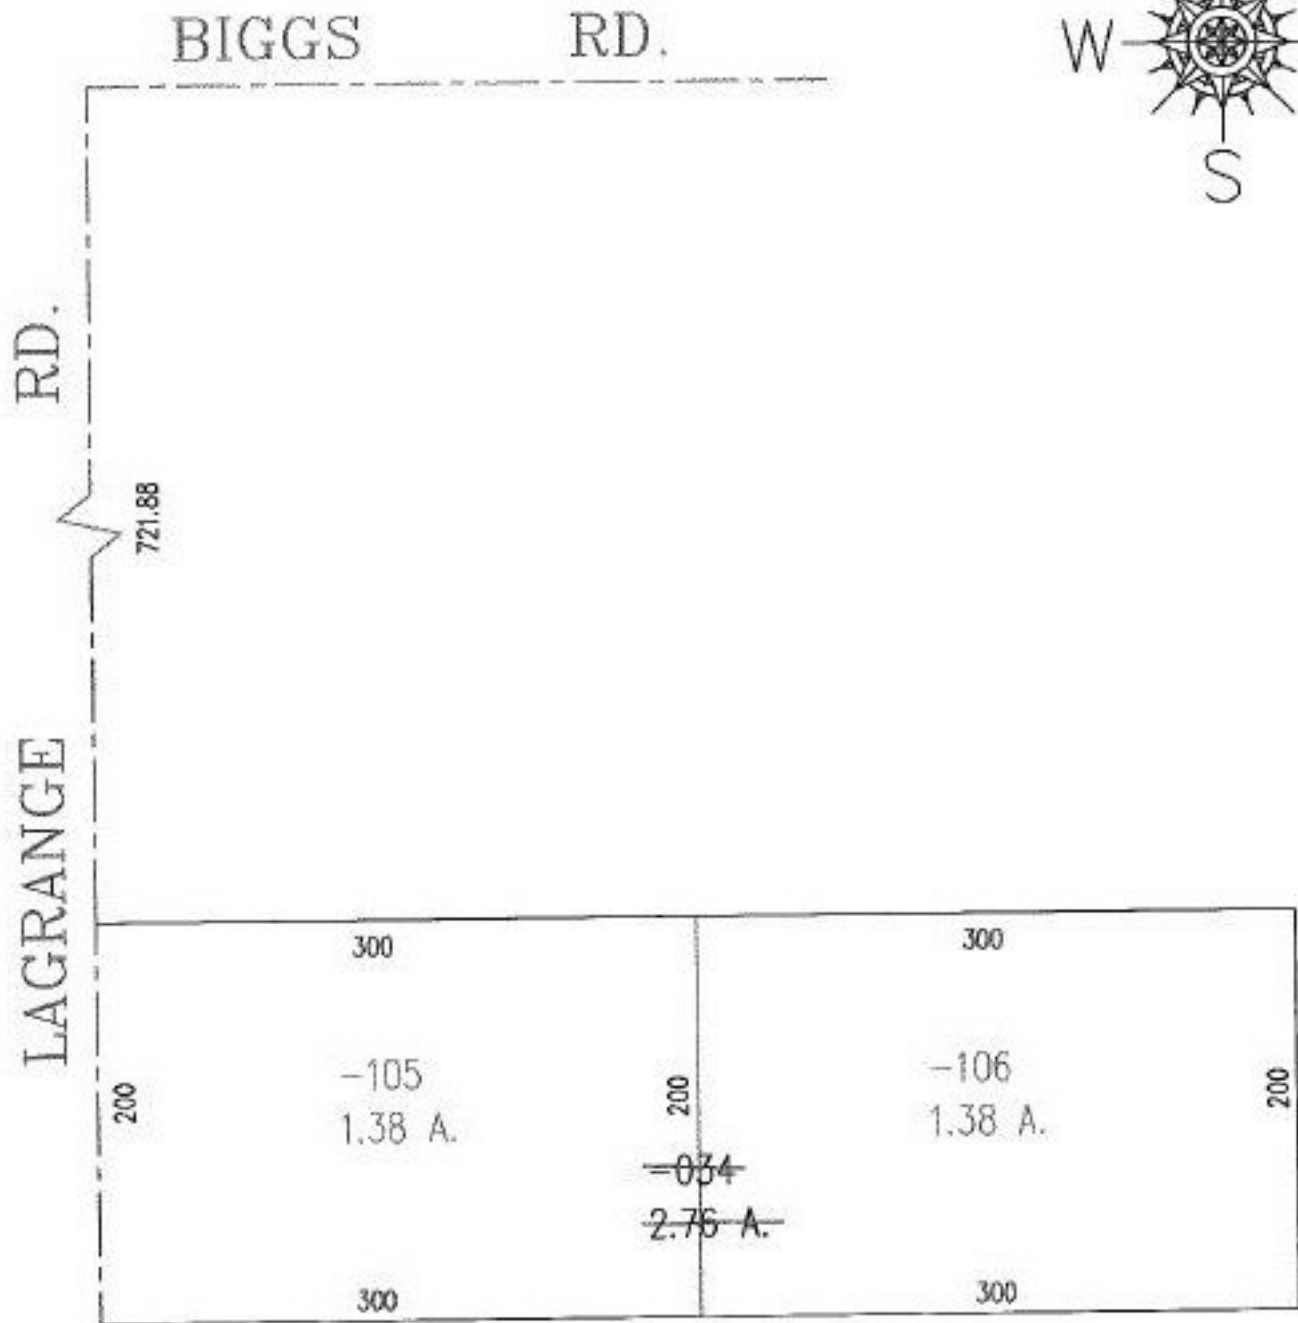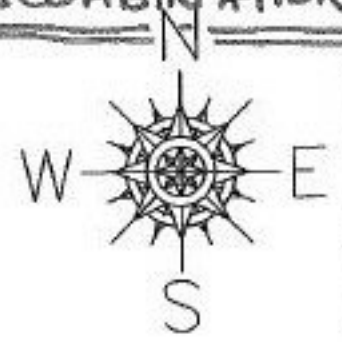

6-21-99
m.B.



SPLITS/DEEDS PROCESSED
 LORAIN COUNTY TAX MAP DEPARTMENT
 226 MIDDLE AVE. ELYRIA, OHIO

SURVEYED BY: DOUG MOSELY
 CLOSURE: CAN'T RUN
 MAP PAGE(S): 15-00-035-A
 APPROVED BY: TJS DATE: 06/26/98
 SCALE: 1" = 100' PRIOR INSTRUMENT: DV 1428/31